

00524

LAND CORNER RECORDATION CERTIFICATE
Filing Requirement of Act 74, Mich. P.A. 1970
Isabella County Remonumentation

SURVEY &
REMONUMENTATION

MAR 09 1999

SECTION

For Corners in

Isabella

(County)

Located In:

Corner Code#:

1. Public Land Survey T. 14N R. 4W K-11
T. R.
T. R.
2. Public Controlling S. T. R.
in Section S. T. R.
3. Miscellaneous S. T. R.
Property in Section S. T. R.
4. Lot No. , Recorded Plat
5. Private Claims

9900000524
Filed for Record in
ISABELLA COUNTY, MI
SHARON A BROWN
On 01-19-1999 At 08:14:45 am.
RE LAND COR 9.00
Liber 1 Page 293 - 293

Register of Deeds Stamp & File Number

I, Jan S. Fokens, in a field survey on September 8, 1998, do hereby certify that under requirements of P.A. 74, Michigan P.A. of 1970, the corner points mentioned in lines 1 and 2 above were in conformance with regulations and rules therefore as required in the current manual of survey instructions of the United States Department of the Interior, Bureau of Land Management or by a decree of a Court of Law and/or that the corner points mentioned in lines 3, 4 and 5 above were in conformance with the rules of the Michigan Board of Land Surveyors or by a Decree of a Court of Law, established, re-established, monumented, re-monumented, recovered, found as expressed below.

NOTE: Not more than 2 corners, all in the same town and range, may be recorded on this certificate.

	A	B	C	D	E	F	G	H	I	J	K	L	M
1													
2	6	5	4	3	2	1							
3													
4	7	8	9	10	11	12							
5													
6	18	17	16	15	14	13							
7													
8	19	20	21	22	23	24							
9													
10	30	29	28	27	26	25							
11													
12	31	32	33	34	35	36							
13													

A. Description of original monument and accessories and/or subsequent restoration:


1. G.L.O Original Survey
Township Lines: 1st quarter 1837 John Hodgson
Subdivision and Resurvey: 4th quarter 1838 R. Whitcomb
Pages 244, 246, 298 Original Field Notes
2. County Survey Records:
Liber 2, Page 395 Dated April 1890 E.R. Coburn
3. L.C.R.C.:
Liber 1, Page 145 A.V. Courtright Recorded date July 16, 1973 Found iron in road.
4. Surveys of Record:
None of record
5. Unrecorded Survey:
Land Surveying Consultants Plat of Survey Distance noted to N. 1/4 Corner, Section 36
Paul B. Lapham & Associates Certificate of Survey Found iron in road, witnesses noted
Land Surveying Consultants Field notes Found plow point
Isabella County Road Commission Alignment Notes Found plow point
M.D.O.T. Road Plans Found plow point Witnesses Noted

- B. Description of corner evidence found and/or method applied in restoring or re-establishing corner:
This corner established in Isabella County Remonumentation Program. See dossier for detailed report.
This is an existent corner.
1. Found plow point
2. Excavated to 2.5'. Found no further evidence.

Accepted as the best available evidence of the position of the original corner and replaced with Standard Monument Corner.


- C. Description of monument for corner and accessories established to perpetuate locating the position of the corner:
Set Standard Isabella County Monument in Monument Box, stamped K-11 and PS 21567.

K-11 SE. Corner, Section 26, T.14N.-R.4W., Union Township, Isabella County
N65°E 48.64' Top center on notch in 16" cmp on N. side of Deerfield Rd.
S53°E 39.63' Top center on notch in 16" cmp on S. side of Deerfield Rd.
S45°W 34.70' Set nail & tag in Elm tree
N42°W 43.96' Found Ruddell tag in power pole
North 2677.80' K-10, E. 1/4 Corner, Section 26, T.14N.-R.4W., Union Township, Isabella County

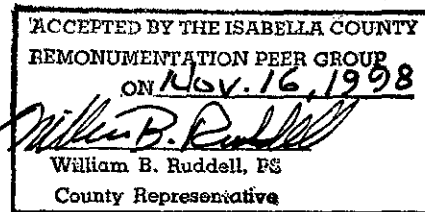

Signed by

Surveyor's Michigan License No. 21567

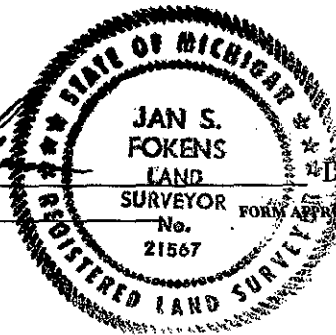

Date 09.30.1998

FORM APPROVED BY MICHIGAN STATE BOARD OF LAND SURVEYORS, JAN.28, 1971
REVISED MAY 14, 1975
REVISED JAN., 1983