


10737

SURVEY &
DOCUMENTATION

JAN 19 2001

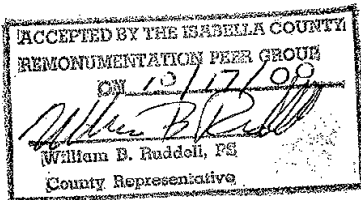

2000 Remonumentation Program
LAND CORNER RECORDATION CERTIFICATE
Filing Requirement of Act 74, Mich. P.A. 1970

SECTION

For corners in

Instrument 10737 Liber 1 Page 356
200000010737
Filed for Record in
ISABELLA COUNTY, MI
SHARON A BROWN
On 12-08-2000 At 02:33:29 pm.
RE LAND COR 9.00
Liber 1 Page 356 - 356

ISABELLA
(County)

Located In: Corner Code
Broomfield Twp.

1. Public Land Survey T 14N R 6W G-1
T R
T R
T R
T R
2. Property Controlling S T R
in Section S T R
3. Miscellaneous S T R
Property in Sec. S T R
4. Lot No. Recorded Plat
5. Private Claims

Register of Deeds Stamp & File Number

I, John H. Rauser, P.S., in a field survey on February 2000, do hereby certify that under requirements of P.A. 74, Michigan P.A. of 1970, the corner points mentioned in lines 1 and 2 above were in conformance with regulations and rules therefore as required in the current manual of survey instructions of the United States Department of the Interior, Bureau of Land Management or by a decree of a Court of Law and/or that the corner points mentioned in lines 3, 4 and 5 above were in conformance with the rules of the Michigan Board of Land Surveyors or by a Decree of a Court of Law; established, re-established, monumented, re-monumented, recovered, found as expressed below:

NOTE: Not more than 4 corners, all in the same town and range, may be recorded on this certificate.

	A	B	C	D	E	F	G	H	I	J	K	L	M
1													
2	6		5		4		3		2		1		
3													
4	7		8		9		10		11		12		
5													
6	18		17		16		15		14		13		
7													
8	19		20		21		22		23		24		
9													
10	30		29		28		27		26		25		
11													
12	31		32		33		34		35		36		
13													

A. Description of original monument and accessories and/or subsequent restoration:

- G-1 Closing Section Corner, Common to Section 3 & 4, T14N-R6W; Broomfield Township, Isabella County
1837 GLO wood post placed 42.56ch (2808.96') North of G-2 by John Milroy, intersected township line 20 lks East of post, two accessories: S19E 21 lks (13.86') 14" Hemlock
S31W 31 lks (20.46') 12" Birch
- 1977 Ruddell Engineering records, HOLLOW SHAFT ON S. SIDE ROCK, Witnessed, NE 26.25' Nail in 15" White Oak, ESE 34.57' Nail in 28" Black Oak, SSW 88.4' Nail in 15" Black Oak, EAST (sic) 13.45' 1" Gas pipe.
- 1999 Act 132, Liber 005, Pg. 738 & 739 by Gary R Stonerock #13601, Found 3/4" pipe in 1' depression 220 East of center of Rolland Rd., witnessed AZ. 45° 25.86' set P.K. w/tag in W face of twin 24" Oak, AZ 180° 14.65' set P.K. w/tag in S. face 42" Oak., AZ 180° 14.65' set P.K. w/tag in W. face 10" Oak, AZ 270° 13.48' find pipe being corner for Sec. 33/34 to the North. Measured 5454.04' to G-3.

B. Description of corner evidence found and/or method applied in restoring or reestablishing corner:


G-1 Closing Section Corner, Common to Section 3 & 4, T14N-R6W; Broomfield Township, Isabella County

Corner is existent. Found no evidence of the original government corner or accessories. Found gun barrel next to 10" x 6" x 8" stone, in remains of east-west fence. Measured 5454.21' to G-3, which is comparable to GLO measurement of 5448.96'. Checked witnesses from 1977 to present. 1977 witness to gas pipe, distance checks good, but direction should be west not east as recorded. Accepted the found gun barrel as the best available evidence of the position of the original government corner.

C. Description of monument for corner and accessories established to perpetuate locating the position of the corner:

G-1 Closing Section Corner, Common to Section 3 & 4, T14N-R6W; Broomfield Township, Isabella County
Set standard Isabella County monument on standard township line, stamped G-1, #39096

N45E 25.86' PK w/tag W. face twin 24" oak OST (1977)
S70E 34.42' PK w/tag S. face 42" oak OST (1977)
South 14.65' PK w/tag W. face twin 10" oak
West 13.48' Found gas pipe at G-13, T15N-R6W

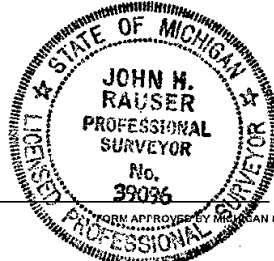

Signed by John H. Rauser
Surveyor's Michigan License No. 39096

Date 12/7/00

FORM APPROVED BY MICHIGAN STATE BOARD OF LAND SURVEYORS, JAN. 28, 1971
REVISED MAY 14, 1975
REVISED JAN., 1983
ADAPTED FOR WORD PROCESSING MARCH, 1995