


JAN 19 2001

SECTION

10736

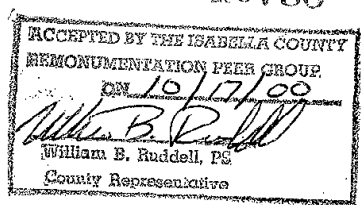

Isabella County Remonumentation Program
LAND CORNER RECORDATION CERTIFICATE
Filing Requirement of Act 74, Mich. P.A. 1970

For corners in

ISABELLA Located In: Corner Code
(County) Sherman Twp.

1. Public Land Survey		<u>T 15N</u>	<u>R 6W</u>	<u>C-3</u>
		<u>T</u>	<u>R</u>	<u></u>
		<u>T</u>	<u>R</u>	<u></u>
		<u>T</u>	<u>R</u>	<u></u>
2. Property Controlling in Section	<u>S</u>	<u>T</u>	<u>R</u>	<u></u>
	<u>S</u>	<u>T</u>	<u>R</u>	<u></u>
3. Miscellaneous Property in Sec.	<u>S</u>	<u>T</u>	<u>R</u>	<u></u>
	<u>S</u>	<u>T</u>	<u>R</u>	<u></u>

4. Lot No. _____, Recorded Plat _____
5. Private Claims _____

I, John H. Rauser, P.S., in a field survey on October 23 20 00, do hereby certify that under requirements of P.A. 74, Michigan P.A. of 1970, the corner points mentioned in lines 1 and 2 above were in conformance with regulations and rules therefore as required in the current manual of survey instructions of the United States Department of the Interior, Bureau of Land Management or by a decree of a Court of Law and/or that the corner points mentioned in lines 3, 4 and 5 above were in conformance with the rules of the Michigan Board of Land Surveyors or by a Decree of a Court of Law; established, re-established, monumented, re-monumented, recovered, found as expressed below:

NOTE: Not more than 4 corners, all in the same town and range, may be recorded on this certificate.

[illegible]

A. Description of original monument and accessories and/or subsequent restoration:

C-3 Section Corner common to Sections 5, 6, 7 & 8 T15N-R6W, Sherman Township, Isabella County
1847 GLO wood post placed by Arron Lynn, D.S., during resurvey of T16N-R6W, listed two accessories:
S67½E 16 lks (10.56') 22" Hemlock
S37W 25 lks (16.5') 32" Pine

1974 Gerald Gray #17741, L.C.R.C. #00325, Found 2" Iron

1988 Ruddell field note witness sheet calls for a found 2" pipe at corner, witnessed by: ENE 97.9' Spike in PP, S10W 64.55' N&C in 8" pine, S85W 30.5' 5" steel fence post, SE 43.1' N&C in top E date pusi (sic)

1997 Certified Survey Act 132, L.005, Pg. 607& 608, Ronald Harris, P.S.# 41917, Fnd. 1-1/4" pipe (L.C.R.C. #325),

B. Description of corner evidence found and/or method applied in restoring or reestablishing corner:

C-3. Description of corner evidence found and/or method applied in restoring or reestablishing corner:
Section Corner common to Sections 5,6,7 & 8 T15N-R6W, Sherman Township, Isabella County
 Corner is existent. Found 1-1/4" x 3.1" pipe with 12"x15"x8" stone on North side, 12"x15"x22" stone on South side, and seven 8" stones surrounding the pipe. At a depth of 3.5' hit the top of a 1"x1-3/4"x20" iron bar. Found rotted wood stake on the South side of said bar, surrounded by 4"-6" stones. Found wood stake is 0.4' East of pipe location. We accepted the found wood stake as a careful and faithful perpetuation of the position of the original government corner.


C. Description of monument for corner and accessories established to perpetuate locating the position of the corner:

C-3 Section Corner common to Sections 5,6,7 & 8 T15N-R6W, Sherman Township, Isabella County

Set standard Isabella County monument over the found wood stake, at approximate P1 of curve in road, 45 feet southwesterly of centerline, 110 feet south along centerline extended and 100 feet west along centerline extended, stamped monument C-3, #39096.

S10E	14.1'	N&T in 8" Box Elder
SE	42.08'	N&T in 9" Elm
ENE	97.48'	Spike in NW'ly side of PP (1988)
S85W	30.9'	Car frame fence post (1974)

Signed by John H. Fausch
Surveyor's Michigan License No. 39096

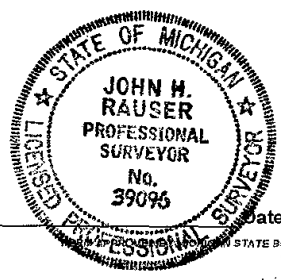

DATE 12/7/00
STATE BOARD OF LAND SURVEYORS, JAN. 23, 1971
REVISED MAY 14, 1975
REVISED JAN. 1983
ADAPTED FOR WORD PROCESSING MARCH, 1995