

SURVEY & REMONUMENTATION

APR 29 1996

COMMISSION

REMONUMENTATION CORNER

LAND CORNER RECORDATION CERTIFICATE

Filing Requirement of Act 74, Mich. P.A. 1970

For corners in ISABELLA
(County)

Located In:

Corner Code #

- | | | | | | |
|------------------------------------|---|-----|---|----|-----|
| 1. Public Land Survey | T | 16N | R | 5W | G-5 |
| | T | | R | | |
| | T | | R | | |
| | T | | R | | |
| 2. Property Controlling in Section | S | | T | R | |
| | S | | T | R | |
| 3. Miscellaneous | S | | T | R | |
| Property in Section | S | | T | R | |
4. Lot No. _____, Recorded Plat _____
5. Private Claims _____

STATE OF MICHIGAN
COUNTY OF ISABELLA
RECEIVED FOR RECORD

DEC 11 10 38 AM '95
000083

SHARON A. BROWN
REGISTER OF DEEDS

Register of Deeds Stamp & File Number

I, PAUL B. LAPHAM, in a field survey on NOVEMBER, 19 95, do hereby certify that under requirements of P.A. 74, Michigan P.A. of 1970, the corner points mentioned in lines 1 and 2 above were in conformance with regulations and rules therefore as required in the current manual of survey instructions of the United States Department of the Interior, Bureau of Land Management or by a decree of a Court of Law and/or that the corner points mentioned in lines 3, 4 and 5 above were in conformance with the rules of the Michigan Board of Professional Surveyors or by a Decree of a Court of Law; established, re-established, monumented, re-monumented, recovered, found as expressed below:

NOTE: Not more than 4 corners, all in the same town and range, may be recorded on this certificate.

A. Description of original monument and accessories and/or subsequent restoration:

1837 NICHOLSON, G.L.O.

1850 BURT, G.L.O. RESURVEY

SET POST

WIT.-(1)CEDAR 9" N11°E 12

(2)CEDAR 6" S17°E 26

1909 TRUSSELL, C.S.R. 4-88

5x5x60 CEDAR STAKE BY PROPORTIONMATE G-SEC 9 TO

G-SEC 16

WIT.-(3)CEDAR 18" S34 1/2°W 70 1/2 L.

(4)CEDAR 12" S64°E 53 1/4 L.

9-20-78 LAPHAM, L.C.R.C. 493

FOUND 5x5 CEDAR STAKE

WIT.-(5)S70°W 13.6' 4" ELM

(6)N10°W 6.2' 5" ASH


(7)S45°E 25.7' 8" ASH

(3)SAME AS #3 ABOVE

(INCLUDED COPY OF FIELD NOTES FROM PBL & A FILES)

B. Description of corner evidence found and/or method applied in restoring or reestablishing corner:

FOUND 5"x30" CEDAR POST (POINTED) FOUND CEDAR STUB S34 1/2°W 46.53 FEET (OBT) AND 9" ELM S70°W 13.6 (OBT).

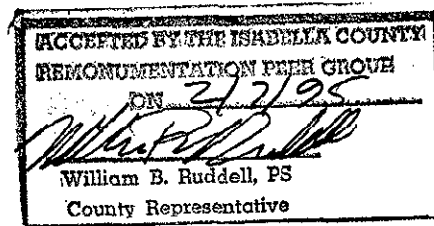

This Corner established in Isabella County Remonumentation Program.

See dossier for detailed report.

C. Description of monument for corner and accessories established to perpetuate locating the position of the corner:

G-5: CORNER COMMON TO SECTIONS 9, 10, 15 & 16

REPLACED CEDAR POST WITH 1/2"x24" STANDARD MONUMENT WITH CAP MARKED G-5, P.S. NO. 9433

SET INSIDE 3/4"x36" PIPE OVER A 1/2"x18" RE-ROD.

ACCEPTED AS BEST AVAILABLE EVIDENCE OF THE PERPETUATION OF THE C.S.R. CORNER.

WITNESSES:

NO2°E 8.10' - NAIL & TAG IN 6" ASH

EAST 30.00' - NAIL & TAG IN 11" ASH

S50°E 26.30' - NAIL & TAG IN 10" ASH

S80°W 24.70' - NAIL & TAG IN 5" ASH

S70°W 13.6' - NAIL & TAG IN 9" ELM (OBT)



Signed by Paul B. Lapham

Date 12-01-95

Surveyor's Michigan License No. 9433