

SECTION

For Corners in Isabella

(County)

Located In:

Corner Code#:

9800001913
Filed for Record in
ISABELLA COUNTY, MI
SHARON A BROWN
On 02-27-1998 At 03:38:23 pm.
RE LAND COR 9.00
Book OR Vol. 1 Pg. 235 - 235

- | | | |
|--|--|---------------|
| 1. Public Land Survey | T. <u>16N.</u> R. <u>5W.</u> | <u>L-1</u> |
| | T. <u> </u> R. <u> </u> | <u> </u> |
| | T. <u> </u> R. <u> </u> | <u> </u> |
| 2. Public Controlling
in Section | S. <u> </u> T. <u> </u> R. <u> </u> | <u> </u> |
| | S. <u> </u> T. <u> </u> R. <u> </u> | <u> </u> |
| 3. Miscellaneous
Property in Section | S. <u> </u> T. <u> </u> R. <u> </u> | <u> </u> |
| | S. <u> </u> T. <u> </u> R. <u> </u> | <u> </u> |
| 4. Lot No. <u> </u> , Recorded Plat <u> </u> | | |
| 5. Private Claims | | |

Register of Deeds Stamp & File Number


I, Mark Robison, in a field survey on October 2, 1997, do hereby certify that under requirements of P.A. 74, Michigan P.A. of 1970, the corner points mentioned in lines 1 and 2 above were in conformance with regulations and rules therefore as required in the current manual of survey instructions of the United States Department of the Interior, Bureau of Land Management or by a decree of a Court of Law and/or that the corner points mentioned in lines 3, 4 and 5 above were in conformance with the rules of the Michigan Board of Land Surveyors or by a Decree of a Court of Law, established, re-established, monumented, re-monumented, recovered, found as expressed below.

NOTE: Not more than 2 corners, all in the same town and range, may be recorded on this certificate.

[illegible]

A. Description of original monument and accessories and/or subsequent restoration:

1. Original G.L.O. Survey:
Township Lines: 2nd Quarter by John Hodgson, 1837
Subdivision & Re-survey: 4th Quarter by Henry Nicholson, 1837
2. County Survey of Records:
Liber 3, Page 165, November 1901, E.R. Coburn
Liber 3, Page 166, November 1901, E.R. Coburn
Sm. Liber 1, Page 64-65, November, 1901, E.R. Coburn
3. L.C.R.C.
None
4. Surveys of Record:
None
5. Unrecorded Surveys:
None

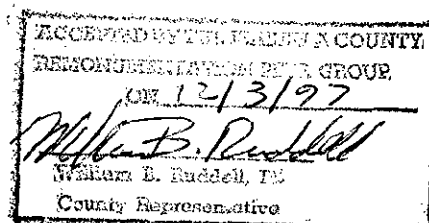

■. Description of corner evidence found and/or method applied in restoring or re-establishing corner:

This corner established in Isabella County Remonumentation Program. See dossier for detailed report.

Measured 5184.78 K-1 to M-1, corner falls 40; East of old fence (recently removed)

Set corner at S.P.M. between M-1 and K-1


2591.22 feet from L-1 to both M-1 and K-1. Corner falls 1.88 feet East of 1974 position.

Accepted as best available evidence of the position of the original corner and replaced with Standard Monument.

Description of monument for corner and accessories established to perpetuate locating the position of the corner:

Set Standard Isabella County Monument in a Monument Box marked PS 27458.

N55°W	48.58'	Nail & Tag in 12" Maple
S80°W	44.60'	Nail & Tag in 13" Ash
S55°W	58.00'	Nail & Tag in 8" Ash
N75°E	26.00'	Nail & Tag in 9" Elm

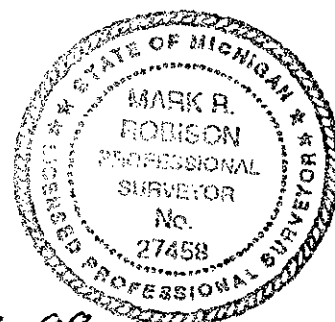

Surveyor's Michigan License No. 27458

Date. 2-26-98