


STATE OF MICHIGAN
DEPARTMENT
OF
NATURAL RESOURCES
LAND CORNER RECORD

JACKSON COUNTY
T 12 R 2E

DESCRIPTION OF CORNER SOUTHWEST CORNER SEC. 15
CORNER MONUMENT 3/4" PINCHED IRON PILE
DATE MONUMENT PLACED AND WITNESSED 3/31/69

WITNESSES TO CORNER..... S 10°W 17.71' PK NAIL + TAG IN DEPT. OF NAT. RES. SIGN
PAST

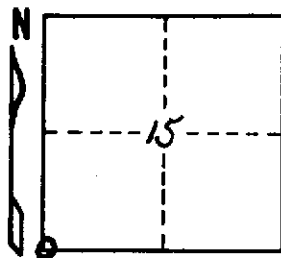


N 38°E 95.75' 17" OAK PK. NAIL + TAG

N 19°W 58.54' TELEPHONE POLE PK NAIL + TAG

AND

CIRCLE CORNER REGISTERED

DESCRIPTION IN DETAIL AS TO HOW CORNER WAS LOCATED AND IDENTIFIED OR RESTORED.

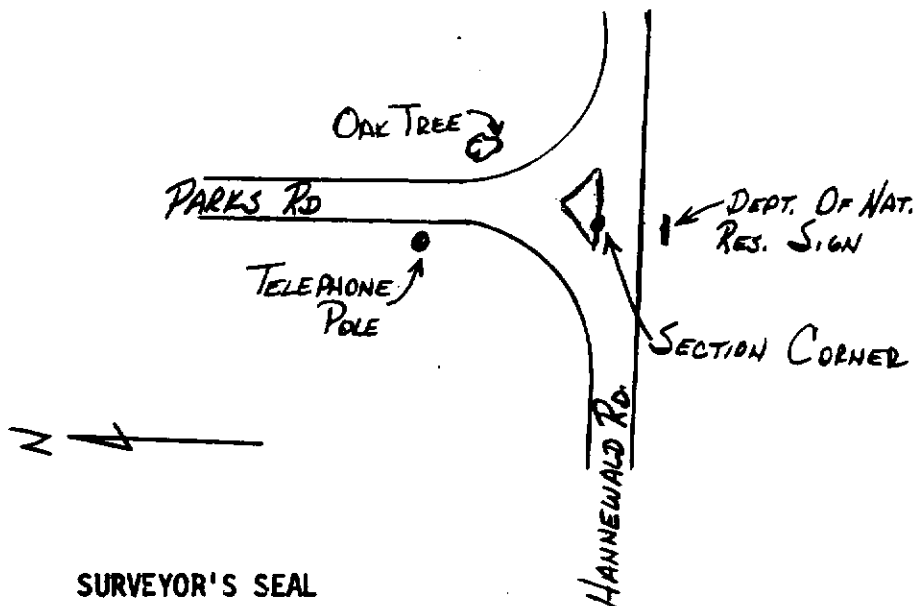

SURVEYOR'S SEAL

DISTRIBUTION:

SIGNED

[Signature]
REGISTERED LAND SURVEYOR

DATE

4/1/69

County Courthouse
Area Forester (Regions I & II)
District or Region Surveyor
Forestry Div., Lansing