

Land Corner Recordation Certificate
Authority: 1970 PA 74, MCL 54.205


Surveyor's Name: Joshua R. Davidson Field Survey Date: April 18, 2017
For corner(s) in: Kalkaska County

Original Public Land Survey Corner			Corner Code
S	T	R	
S	T	R	
S	T	R	
S	T	R	

Property Controlling Corner				Corner Code
S	21, 22	T 25N	R 5W	10
S	22	T 25N	R 5W	11
S		T	R	
S		T	R	

Property Corner			Corner Code
S	T	R	
S	T	R	
S	T	R	
S	T	R	

Protracted Public Land Survey Corner			Corner Code
S	T	R	
S	T	R	
S	T	R	
S	T	R	

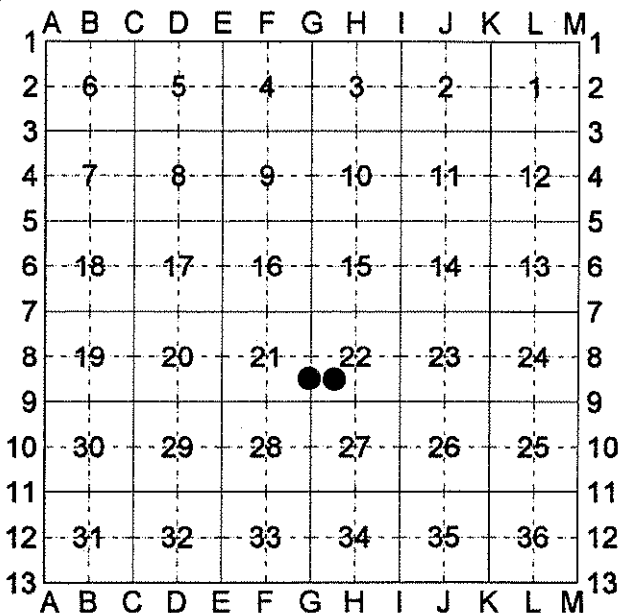

Part A: Corner History

10 – S 1/16 corner common to sections 21 & 22 T25N R5W 11 – SW 1/16 corner section 22 T25N, R5W
– None – None

Part B: Surveyor's Report on Perpetuation, Restoration, Reestablishment, or Monumentation of Corner

10 – S 1/16 corner common to sections 21 & 22 T25N R5W 11 – SW 1/16 corner section 22 T25N, R5W

Set a stamped 2" aluminum cap on 5/8" x 34" rebar per BLM standard procedure.

Set a stamped 2" aluminum cap on 5/8" x 34" rebar per BLM standard procedure.

Part C: Field Evidence of Perpetuation or Monumentation of Corner

10 – S 1/16 corner common to sections 21 & 22 T25N R5W 11 – SW 1/16 corner section 22 T25N, R5W

a stamped 2" aluminum cap on 5/8" x 34" rebar.


a stamped 2" aluminum cap on 5/8" x 34" rebar.

N50°E 87.65' to set nail & tag in SE. side 38" Oak
S89°56'E 42.59' to 2" aluminum cap on 5/8" x 34" rebar
S14°W 110.33' to set nail & tag in E. side 14" Oak
N18°W 44.93' to set nail & tag in W. side 16" quad Maple

N42°E 39.63' to set nail & tag in NW. side 8" Oak
S48°E 38.64' to set nail & tag in SW. side 15" Oak
S50°W 44.46' to set nail & tag in SE. side 5" Oak
N68°W 38.37' to set nail & tag in SW. side 30" Oak

Set blue post with location tag 1' Northeast

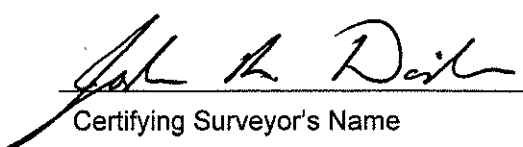


Certifying Surveyor's Name

February 1, 2018

Date

Professional Surveyor's License No.: 46659

Prepared By: Joshua R. Davidson
Department of Natural Resources
8015 Mackinaw Trail
Cadillac, MI 49601