



DOCUMENT # 3139115
STATE OF MICHIGAN
KALKASKA COUNTY
RECORDED: 02/05/2018 4:11 PM
PAGES: 2
RECORDING FEES: 30.00
JOANN DEGRAAF
REGISTER OF DEEDS
BK: 4 PG: 23

Land Corner Recordation Certificate

Authority: 1970 PA 74, MCL 54.205

Surveyor's Name: Joshua R. Davidson

Field Survey Date: November 6, 2017

For corner(s) in: Kalkaska County

Original Public Land Survey Corner

Corner Code

S 9, 10, 15, 16 T 25N R 6W
S 15, 16 T 25N R 6W
S T R
S T R

G5
G6

Property Controlling Corner

Corner Code

S T R
S T R
S T R
S T R

Property Corner


Corner Code

S T R
S T R
S T R
S T R

Protracted Public Land Survey Corner

Corner Code

S T R
S T R
S T R
S T R

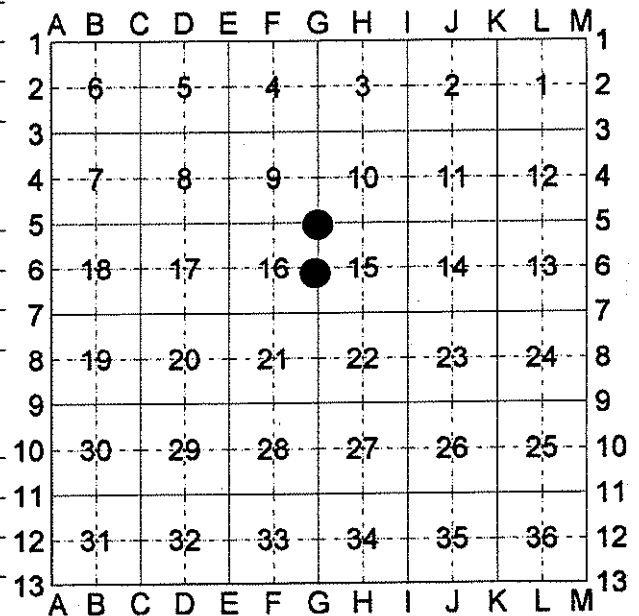

Part A: Corner History

G5 – corner common to sections 9, 10, 15 & 16 T25N R6W G6 – ¼ corner common to sections 15 & 16, T25N, R6W

- 1852 – GLO – Cannon – set post corner of sections 9, 10, 15 & 16. –
1) Tamarack 14" S57°W 8. 2) Tamarack 12 N57°E 17.
- 1852 – GLO – set quarter section post –
1) Tamarack 8" N22°E 50.
2) Balsam 6" S73°W 9.
- 1940 – Marcus Schaaf – field notes, book T25N, R6W, page 46 – Both BT stumps in place, but post rotting, exact. Also an old squared cedar stake rotted off and on ground. Corner in swamp about 2.75 ch from East edge of swamp. –
3) W. Pine stump 24" S82½°E .92
4) W. Pine stump 28" S28°E 1.53
5) W. Pine stump 26" S75°W 1.49
- 1954 – DNR Corner Record – Dean C. DeLamater, PS# 5778 – This corner was located by Forestry Division survey crew, while making a partial resurvey of the township. Corner was previously established by Marcus Schaaf, Registered Land Surveyor in 1940. Original BT's in place but very poor condition.
– 1" pipe with 4" brass cap. –
5) 12" Cedar S70°W 23½ links
6) 5" Cedar N40°W 45 links

Part B: Surveyor's Report on Perpetuation, Restoration, Reestablishment, or Monumentation of Corner

G5 – corner common to sections 9, 10, 15 & 16 T25N R6W G6 – ¼ corner common to sections 15 & 16, T25N, R6W

Found 4" department of conservation brass cap on 1" pipe. Found accessories #2(stump remains), #5(dead stub) & #6 fitting position of monument. Accepted the position of found 4" department of conservation brass cap on 1" pipe as a careful and faithful perpetuation of the position of the original corner.

Searched area near single proportion position. Found possible Schaaf pit to the Northwest. Schaaf set monuments at G5 and G7, but have no record of him setting a monument at G6. Dug a 4' X 6' search area from the possible Schaaf pit in search of monument or wood stake. Nothing found. Set a stamped 4" DNR aluminum cap on 1" X 36" long galvanized iron pipe at single proportion position. N58°W 31.8' to possible Schaaf pit. Accepted 4" DNR aluminum cap on 1" X 36" long galvanized iron pipe as a careful and faithful reestablishment of the position of the original corner.

Part C: Field Evidence of Perpetuation or Monumentation of Corner

G5 – corner common to sections 9, 10, 15 & 16 T25N R6W G6 – ¼ corner common to sections 15 & 16, T25N, R6W

a 4" department of conservation brass cap on 1" pipe.
– Set blue post 1' Northeast.

a stamped 4" DNR aluminum cap on 1" X 36" long galvanized iron pipe. – Set blue post 1' North.

S87°E 19.14' to set nail & tag in NE. side 6" Black Spruce
S53°W 42.82' to set nail & tag in NW. side 12" Cedar
N36°W 30.02' to set nail & tag in NE. side 12" Cedar
N07°W 37.02' to set nail & tag in W. side 11" Cedar

N25°E 56.39' to set nail & tag in SE. side 7" J. Pine
S37°E 5.41' to set nail & tag in SW. side 6" W. Pine
S23°W 61.05' to set nail & tag in NW. side 7" J. Pine
N52°W 27.70' to set nail & tag in NE. side 3" W. Pine

Joshua R. Davidson
Certifying Surveyor's Name

February 1, 2018
Date

Professional Surveyor's License No.: 46659

Prepared By: Joshua R. Davidson
Department of Natural Resources
8015 Mackinaw Trail
Cadillac, MI 49601

