

STATE OF MICHIGAN  
DEPARTMENT  
OF  
NATURAL RESOURCES  
LAND CORNER RECORD


KALKASKA COUNTY  
T 25 N R 7 W

DESCRIPTION OF CORNER NE CORNER SECTION 32

CORNER MONUMENT Added DNR Monument w/Cedar Guard Post

DATE MONUMENT PLACED AND WITNESSED 1-11-72

WITNESSES TO CORNER..... Telephone Pole N 78 W 58.76'

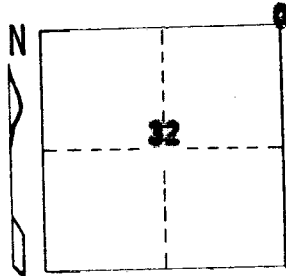

7" Spruce N 60 W 127.9'


4" Cedar N 38 E 31.6'

AND

CIRCLE CORNER REGISTERED

DESCRIPTION IN DETAIL AS TO HOW CORNER WAS LOCATED AND IDENTIFIED OR RESTORED.

Recovered Fargo Corner, 1912, 3/4" pipe, per M.D.S.N. survey. Fargo had an original U.S. corner.

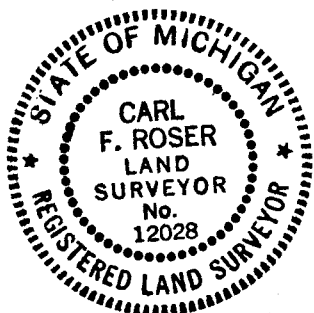

SURVEYOR'S SEAL

*Carl F. Roser*

SIGNED

DATE 1-18-72

DISTRIBUTION:

REGISTERED LAND SURVEYOR 12028

County Courthouse  
Area Forester (Regions I & II)  
District or Region Surveyor  
Forestry Div., Lansing

R 4047  
Rev. 10/68