

# LAND CORNER RECORDATION CERTIFICATE

Filing Requirement of Act 74, Mich. PA 1970

For Corners In: Kalkaska Located In \_\_\_\_\_ Corner Code # \_\_\_\_\_  
(County)

1. Public Land Survey T \_\_\_\_\_ R \_\_\_\_\_  
T \_\_\_\_\_ R \_\_\_\_\_  
2. Property Controlling in Section S 24 T 25N R 7W 4  
S 24 T 25N R 7W CENW1/64  
3. Miscellaneous Property in Section S \_\_\_\_\_ T \_\_\_\_\_ R \_\_\_\_\_  
S \_\_\_\_\_ T \_\_\_\_\_ R \_\_\_\_\_


4. Lot No: \_\_\_\_\_ Recorded Plat: \_\_\_\_\_

5. Private Claims: \_\_\_\_\_

I, Craig W. McVean, in a field survey on March 23, 2004 do hereby state that under requirements of PA 74, Michigan PA of 1970, the corner points mentioned in lines 1 and 2 above were in conformance with regulations and rules therefore as required in the current manual of survey instructions of the United States Department of the Interior, Bureau of Land Management or by a decree of a Court of Law and/or that the corner points mentioned in lines 3, 4 and 5 above were in conformance with the rules of the Michigan Board of Land Surveyors or by a Decree of a Court of Law; established, re-established, monumented, recovered, found as expressed below:

**NOTE: Not more than 2 corners, all in the same town and range, may be recorded on this certificate.**

A. Description of original monument and accessories and/or subsequent restoration:  
4 - None CENW 1/64 - None

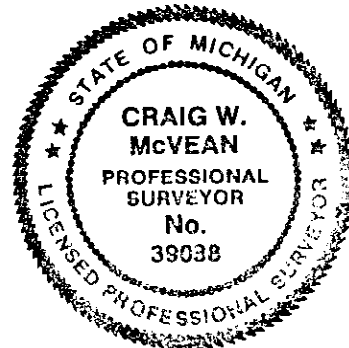

B. Description of corner evidence found and/or method applied in restoring or re-establishing corner:  
4 - NW 1/16 Cor. Sec. 24 - Set 2" Alum. Cap on 5/8" x 34" iron rebar per standard BLM procedure. CENW 1/64 - being the SW Cor. of the E 1/2 of NE 1/4 of NW 1/4 Sec. 24 - Set 2" Alum. Cap on 5/8" x 34" iron rebar per Standard BLM procedure.

C. Description of monument for corner and accessories established to perpetuate locating the position of the corner:  
4 - Stamped 2" Alum. Cap on 5/8" x 34" iron rebar CENW 1/64 - Stamped 2" Alum. Cap on 5/8" x 34" iron rebar  
N30°E 16.96' to set N & T in NW side 6" Cedar West 10.38' to set N & T in N. side 9" R. Pine  
S77°E 9.55' to set N & T in N. side 9" R. Maple N9°W 12.64' to set N & T in W. side 20" R. Pine  
S6°W 28.85' to set N & T in W. side 21" R. Pine S3°E 9.41' to set N & T in W. side 7" R. Pine  
S77°W 21.81' to set N & T in S. side 10" Cedar S61°E 8.24' to set N & T in SW side Tw. 7" W. Pine  
Set blue carsonite post w/ loc. tag 1' SW Set blue carsonite post w/ loc tag 1' SE

Signed by:

Craig W. McVean

Date:

8/3/2004

Surveyor's Michigan License No.:

39088