

LAND CORNER RECORDATION CERTIFICATE

Filing Requirement of Act 74, Mich. PA 1970

For Corners In:

Kalkaska

(County)

Located In

Corner Code #

1. Public Land Survey

T _____ R _____
T _____ R _____

2. Property Controlling
in Section

S 24 T 25N R 7W 10

S 23/24 T 25N R 7W SS1/64

3. Miscellaneous
Property in Section

S _____ T _____ R _____

S _____ T _____ R _____

4. Lot No: _____

Recorded Plat: _____

5. Private Claims: _____

I, Craig W. McVean, in a field survey on March 23, 2004 do hereby state that under requirements of PA 74, Michigan PA of 1970, the corner points mentioned in lines 1 and 2 above were in conformance with regulations and rules therefore as required in the current manual of survey instructions of the United States Department of the Interior, Bureau of Land Management or by a decree of a Court of Law and/or that the corner points mentioned in lines 3, 4 and 5 above were in conformance with the rules of the Michigan Board of Land Surveyors or by a Decree of a Court of Law; established, re-established, monumented, recovered, found as expressed below:


NOTE: Not more than 2 corners, all in the same town and range, may be recorded on this certificate.

A. Description of original monument and accessories and/or subsequent restoration:

10 - None

SS 1/64 - None

	A	B	C	D	E	F	G	H	I	J	K	L	M
1													
2	6			5			4			3		2	1
3													
4	7			8			9			10		11	12
5													
6	18			17			16			15		14	13
7													
8	19			20			21			22		23	24
9													
10	30			29			28			27		26	25
11													
12	31			32			33			34		35	36
13													

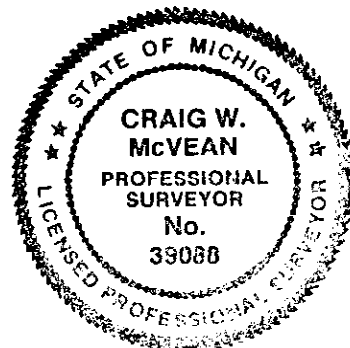

B. Description of corner evidence found and/or method applied in restoring or re-establishing corner:

10 - S 1/16 Cor. Common to Sec. 23 & 24 -

Set 2" Alum. Cap on 5/8" x 34" iron rebar per standard BLM procedure.
Corner in Cedar swamp.

SS 1/64 - Cor. common to Sec. 23 & 24 - being the NW Cor.

of the S 1/2 of SW 1/4 of SW 1/4. Sec. 24 -
Set 2" Alum. Cap on 5/8" x 34" iron rebar per standard BLM procedure. Centerline of 2-track NW - SE is 84' N

C. Description of monument for corner and accessories established to perpetuate locating the position of the corner:

10 - Stamped 2" Alum. Cap on 5/8" x 34" iron rebar -

Set blue carsonite post w/ loc. tag 1' NW
S49°E 2.96' to set N & T in NE side 11" Cedar
S56°W 10.69' to set N & T in SE side 8" Cedar
N51°W 17.15' to set N & T in SW side 10" Cedar
N30°E 16.84' to set N & T in NW side 10" Cedar

SS 1/64 - Stamped 2" Alum. Cap on 5/8" x 34" iron rebar -

Set blue carsonite post w/ loc. tag 1' SW
S44°E 21.37' to set N & T in NE side 14" W. Pine
S6°W 22.75' to set N & T in E side 18" R. Pine
S60°W 30.09' to set N & T in S side 16" W. Pine
N47°W 16.39' to set N & T in W side 12" R. Pine

Signed by:

Craig W. McVean

Date:

8/3/2004

Surveyor's Michigan License No.:

39088