Tx:4016447 11/29/2012 1:00:00 PM


LAND CORNER RECORDATION CERTIFICATE

Filing Requirement of Act 74, Mich. PA 1970


For Corners In: Kalkaska (County)		Locate	ed In	Corner Code #
1. Public Land Survey		T 26N	R 6W	F9
Property Controlling in Section	s	T	R	
Miscellaneous Property in Section	s s	' ——— T	R	
	s	Т	R	
4. Lot No:	Recorde	d Plat:		
5. Private Claims:	<u>.</u>			
I, Joshua R. Davidson, in a	field survey	on August	8, <u>2012</u> do he	reby state that under

DOCUMENT # 3111414 JOANN DEGRAAF KALKASKA CTY ROD KALKASKA, MI RECORDED ON 11/29/2012 1:31 PM **REC FEE: 14.00** PAGES: 1 BK: 3PG: 338

Register of Deeds Stamp & File Number

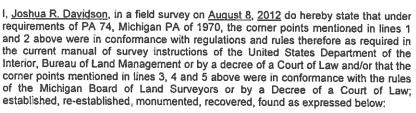

NOTE: Not more than 2 corners, all in the same town and range, may be recorded on this certificate.

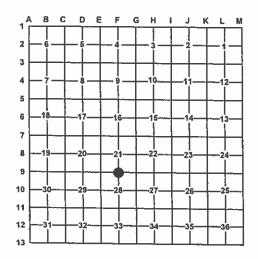

A. Description of original monument and accessories and/or subsequent restoration:

<u>F9</u> - 1852 - GLO - G. Cannon - set 1/4 sec. post 1) Cedar 12" S26°E 25

- 2) Cedar 14" N20°W 9

- B. Description of corner evidence found and/or method applied in restoring or re-establishing corner:
- F9 1/4 Corner common to sections 21, & 28, T26N, R6W. Searched calculated area for GLO evidence. Area had been logged and disturbed by equipment. Found stumps of cedars that had been cut in the area, but could not fit two together to determine GLO position. Set a 4" DNR aluminum cap on a 1" X 36" galvanized iron pipe by single proportion between section corners E9 and G9. DNR monument accepted as a careful and faithful reestablishment of the position of the original corner.
- C. Description of monument for corner and accessories established to perpetuate locating the position of the corner:
- F9 Set stamped 4" DNR aluminum cap on 1" X 36" galvanized iron pipe.

N75°E 42.79' to set nail & tag in N. side 4" R. Maple scribed "XBT" S56°E 27.18' to set nail & tag in SW. side 6" Ash S18°W 20.44' to set nail & tag in W. side 3" R. Maple N10°W 50.74' to set nail & tag in E. side 5" Ash Set blue carsonite post 1' West

OF MICH JOSHUA R DAVIDSON ROFESSIONA SURVEYOR POFESSIONA

Signed by:

Surveyor's Michigan License No.:

46659

Date:

11-29-2012