

SURVEY &  
REMONUMENTATION

FEB 13 1998

SECTION

LAND CORNER RECORDATION CERTIFICATE  
Filing Requirement of Act 74, Mich. P.A. 1970

For corners in

KALKASKA  
(County)

Located In:

Corner Code #

1997 REMONUMENTATION

1. Public Land Survey

T.26N R.7W

A-9

T. R.

T. R.

T. R.

2. Property Controlling  
in Section

S. T. R.

S. T. R.

3. Miscellaneous  
Property in Sec.

S. T. R.

S. T. R.

Register of Deeds Stamp & File Number

4. Lot No. , Recorded Plat

5. Private Claims

I, EUGENE FARRIER, in a field survey on OCTOBER 28, 1997

do hereby state that under requirements of P.A. 74, Michigan P.A. of 1970, the corner points mentioned in lines 1 and 2 above were in conformance with regulations and rules therefore as required in the current manual of survey instructions of the United States Department of the Interior, Bureau of Land Management or by a decree of a Court of Law and /or that the corner points mentioned in lines 3, 4 and 5 above were in conformance with the rules of the Michigan Board of Land Surveyors or by a Decree of a Court of Law; established, re-established, monumented, recovered, found as expressed below:

NOTE: Not more than 2 corners, all in the same town and range, may be recorded on this certificate.

	A	B	C	D	E	F	G	H	I	J	K	L	M
1													
2	6		5		4		3		2		1		
3													
4	7		8		9		10		11		12		
5													
6	18		17		16		15		14		13		
7													
8	19		20		21		22		23		24		
9													
10	30		29		28		27		26		25		
11													
12	31		32		33		34		35		36		
13													

A. Description of original monument and accessories and/or subsequent restoration:

A-9: Sec. Cor. common to Sec. 19 & 30, T26N-R7W, Orange Township

1849, GLO resurvey, set Beech post, 20" Sugar S52E, 19, 20" Sugar N52E, 22

04-27-1901, W.S. Merrill, Co. Surveyor, working in Sec. 25, T26N-R8W, noted falling of 1.78


02-22-1980, N.L. Parker #16939, Cert. Survey, w/accessories, Lib. 2, Pg. 544

07-09-1982, Farrier Surveying, Fd. 1/2" iron rod, w/accessories

B. Description of corner evidence found and/or method applied in restoring or reestablishing corner:

A-9: Sec. Cor. common to Sec. 19 & 30, T26N-R7W, Orange Township

Fd 1/2" x 24" rod, 1' West of C.L. Puffer Rd. & 8' South of C.L. Hall Rd. To East and on Standard line. Pulled and replaced with 5/8" x 18" rebar w/brass cap in Mon. box. No GLO witnesses were fd. The Kalkaska Co. Peer group approved the above monument as a careful and faithful reestablishment of the position of the original corner.

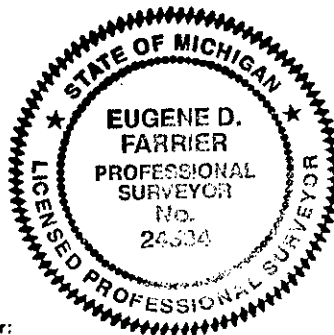

C. Description of monument for corner and accessories established to perpetuate locating the position of the corner:

A-9: Sec. Cor. common to Sec. 19 & 30, T26N-R7W, Orange Township

Fd 1/2" x 24" rod, 1' West of C.L. Puffer Rd. & 8' South of C.L. Hall Rd. To East. Pulled and replaced with 5/8" x 18" rebar w/brass cap in Mon. box.

Fd. N02E, Kalkaska Co. Mon., 116.29' (Standard corner)

Fd. Nail N60W, P. Pole, 94.63'

Set nail & tag, S40W, W. Post, 54.22'

Fd N74E, stop sign, 37.05'

Ratified by Peer Group

P.A. 345 - 1990 Kalkaska County

Chairman Eugene Farrier

Date 1-29-98

Signed by Eugene Farrier  
Surveyor's Michigan License No. 24594

Date 2-3-98



3004815

Page: 1 of 1

02/04/98 11:22A

LB: 5 PG: 219

FORM APPROVED BY MICHIGAN STATE BOARD OF PROFESSIONAL SURVEYORS, JAN. 28, 1971  
REVISED MAY 14, 1976  
REVISED JAN., 1983  
REVISED OCT., 1995