

SURVEY & REMONUMENTATION

FEB 13 1998

SECTION

LAND CORNER RECORDATION CERTIFICATE
Filing Requirement of Act 74, Mich. P.A. 1970

For corners in

| | | |
|------------------------------------|--------------------------|---------------|
| <u>KALKASKA</u> (County) | Located In: | Corner Code # |
| 1997 REMONUMENTATION | | |
| 1. Public Land Survey | T <u>26N</u> R <u>7W</u> | <u>D-11</u> |
| | T _____ R _____ | _____ |
| | T _____ R _____ | _____ |
| | T _____ R _____ | _____ |
| 2. Property Controlling in Section | S _____ T _____ R _____ | _____ |
| | S _____ T _____ R _____ | _____ |
| 3. Miscellaneous Property in Sec. | S _____ T _____ R _____ | _____ |
| | S _____ T _____ R _____ | _____ |

Register of Deeds Stamp & File Number

4. Lot No. _____, Recorded Plat _____

5. Private Claims _____


I, EUGENE FARRIER, in a field survey on OCTOBER 24, 1997 do hereby state that under requirements of P.A. 74, Michigan P.A. of 1970, the corner points mentioned in lines 1 and 2 above were in conformance with regulations and rules therefore as required in the current manual of survey instructions of the United States Department of the Interior, Bureau of Land Management or by a decree of a Court of Law and for that the corner points mentioned in lines 3, 4 and 5 above were in conformance with the rules of the Michigan Board of Land Surveyors or by a Decree of a Court of Law; established, re-established, monumented, recovered, found as expressed below:

NOTE: Not more than 2 corners, all in the same town and range, may be recorded on this certificate.

| | | | | | | | | | | | | | |
|----|----|---|----|---|----|---|----|---|----|---|----|---|---|
| | A | B | C | D | E | F | G | H | I | J | K | L | M |
| 1 | | | | | | | | | | | | | |
| 2 | 6 | | 5 | | 4 | | 3 | | 2 | | 1 | | |
| 3 | | | | | | | | | | | | | |
| 4 | 7 | | 8 | | 9 | | 10 | | 11 | | 12 | | |
| 5 | | | | | | | | | | | | | |
| 6 | 18 | | 17 | | 16 | | 15 | | 14 | | 13 | | |
| 7 | | | | | | | | | | | | | |
| 8 | 19 | | 20 | | 21 | | 22 | | 23 | | 24 | | |
| 9 | | | | | | | | | | | | | |
| 10 | 30 | | 29 | | 28 | | 27 | | 26 | | 25 | | |
| 11 | | | | | | | | | | | | | |
| 12 | 31 | | 32 | | 33 | | 34 | | 35 | | 36 | | |
| 13 | | | | | | | | | | | | | |

A. Description of original monument and accessories and/or subsequent restoration:
D-11: Cor. Common to Sec. 29 & 32, T26N-R7W Orange Twp.
1849, GLO, resurvey, set Hemlock post, 18" Hemlock N60E, 31, 24" Beech S35W, 18
11-22-1890, W.S. Merrill, County Surveyor, established cor. S.P.M., no accessories
04-02-1910, County Surveyor, used cor., no accessories
10-1973, J.L. Wilcox #14102, LCR, fd. 1" square bar, w/accessories, Lib. 1, Pg. 301
11-5-1973, Wilcox, Erickson & Assoc. Inc., Cert. Survey, fd. 1" sq. Bar, w/accessories, Lib. 1, Pg. 495
01-1977, DNR map, fd. 3/4" iron, no accessories
04-04-1987, Farrier Surveying, Cert. Survey, fd. 1" bar (witnesses, Lib. 1, Pg. 301)

B. Description of corner evidence found and/or method applied in restoring or reestablishing corner:
D-11: Cor. Common to Sec. 29 & 32, T26N-R7W Orange Twp.
Fd. 1" square x 14" iron bar, 2' South of CL Montgomery Rd. Pulled and replaced with 5/8" x 18" rebar, w/brass cap. No GLO witnesses were fd. The Kalkaska Co. Peer group approved and accepted the above monument as a careful and faithful reestablishment of the position of the original corner.

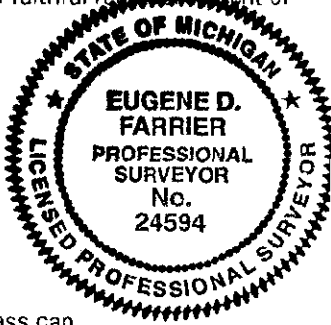

C. Description of monument for corner and accessories established to perpetuate locating the position of the corner:
D-11: Cor. Common to Sec. 29 & 32, T26N-R7W Orange Twp.
Fd. 1" square x 14" iron bar, 2' South of CL Montgomery Rd. Pulled and replaced with 5/8" x 18" rebar, w/brass cap.
Set nail & tag N07E, 16" Maple, 33.09'
Set nail & tag S24E, 10" R. Pine, 66.57'
Set nail & tag South, 10" R. Pine, 59.35'
Fd. Nail N55W, 18" Maple, 54.31'

Ratified by Peer Group
P.A. 345 - 1990 Kalkaska County
Chairman Eugene Farrier
Date 1-29-98

Signed by Eugene Farrier
Michigan License No. 24594

Date 2-3-98 Surveyor's



3004834
Page: 1 of 1
02/04/98 11:22A