

LAND CORNER RECORDATION CERTIFICATE

Filing Requirement of Act 74, Mich. PA 1970

For Corners In:
Kalkaska
(County)

Located In

Corner Code #

1. Public Land Survey T 27N R 8W C8
T R
2. Property Controlling in Section S T R
S T R
3. Miscellaneous Property in Section S T R
S T R

4. Lot No: Recorded Plat:

5. Private Claims:

I, Craig W. McVean, in a field survey on June 27, 2002 do hereby state that under requirements of PA 74, Michigan PA of 1970, the corner points mentioned in lines 1 and 2 above were in conformance with regulations and rules therefore as required in the current manual of survey instructions of the United States Department of the Interior, Bureau of Land Management or by a decree of a Court of Law and/or that the corner points mentioned in lines 3, 4 and 5 above were in conformance with the rules of the Michigan Board of Land Surveyors or by a Decree of a Court of Law, established, re-established, monumented, recovered, found as expressed below:

NOTE: Not more than 2 corners, all in the same town and range, may be recorded on this certificate.

Register of Deeds Stamp & File Number

| | A | B | C | D | E | F | G | H | I | J | K | L | M |
|----|----|----|----|----|----|----|---|---|---|---|---|---|---|
| 1 | | | | | | | | | | | | | |
| 2 | 6 | 5 | 4 | 3 | 2 | 1 | | | | | | | |
| 3 | | | | | | | | | | | | | |
| 4 | 7 | 8 | 9 | 10 | 11 | 12 | | | | | | | |
| 5 | | | | | | | | | | | | | |
| 6 | 18 | 17 | 16 | 15 | 14 | 13 | | | | | | | |
| 7 | | | | | | | | | | | | | |
| 8 | 19 | 20 | 21 | 22 | 23 | 24 | | | | | | | |
| 9 | | | | | | | | | | | | | |
| 10 | 30 | 29 | 28 | 27 | 26 | 25 | | | | | | | |
| 11 | | | | | | | | | | | | | |
| 12 | 31 | 32 | 33 | 34 | 35 | 36 | | | | | | | |
| 13 | | | | | | | | | | | | | |

A. Description of original monument and accessories and/or subsequent restoration:


C8 - GLO - set 1/4 post - L. Lyon - 1850
Y. Pine 14" N22°E 40 L.
B. Oak 12" S40°W 14 L.
- M. Schaaf - 1928 - Ran random line
Doesn't note finding corner
- DNR cor. record - 1967 - K.J. Ostling
Set cons. Dept. mon. by proportionate measurement
between section corners during a survey of Sec. 20.
Could not locate a previous corner after extensive search.
Checks S. edge of Darby Lake very well. Falls on W. edge
of N-S Firelane.
7" W. Pine N36°W 6.7'
7" W. Pine S20°W 11.8'

B. Description of corner evidence found and/or method applies in restoring or re-establishing corner:

C8 - 1/4 corner common to Sec. 19 & 20 - Fd. 4" DOC (DNR) Alum. cap on 1" Galv. Iron pipe per Ostling. CL of N-S firelane is 21' E. Measured N. 298'± 5' (298'-GLO) to apparent high water mark of Darby Lake. Water line is now 60'± N of high water line. DOC mon. accepted as a careful & faithful re-establishment of the position of the original corner.

C. Description of monument for corner and accessories established to perpetuate locating the position of the corner:

C8 - 4" DOC (DNR) Alum. cap on 1" Galv. iron pipe.
N 1' to set blue carsonite post.
N38°W 6.96' to set N&T in SW side 17" W. Pine (KJO)
S83°W 10.88' to set N & T in N side 8" R. Maple
S19°E 7.12' to set N & T in W side 13" R. Oak
N40°E 43.00 to set N & T in NW side 3" W. Pine

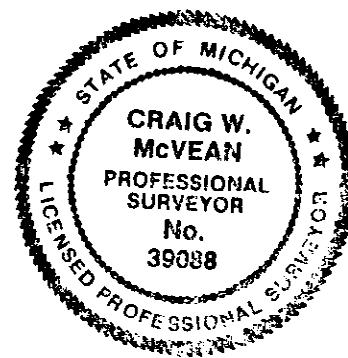

Signed by: Craig W. McVean
Surveyor's Michigan License No.: 39088

Date: 12/9/2003