

# LAND CORNER RECORDATION CERTIFICATE

FILING REQUIREMENT OF ACT 74, MICH. P.A.1970

FOR CORNERS OF--	LOCATED IN--	CORNER CODE NUMBER
1. PUBLIC LAND SURVEY_____ T. _____ N. S., R. _____ E. W.		
2. PROPERTY CONTROLLING IN SECTION <u>20</u> , T. <u>28</u> N. S., R. <u>5</u> E. W.		<u>14</u> ; <u>13</u>
3. MISCELLANEOUS PROPERTY IN SECTION _____ , T. _____ N. S., R. _____ E. W.		
4. LOT NO. _____ , RECORDED PLAT _____		
5. PRIVATE CLAIMS _____		

REGISTER OF DEEDS STAMP AND  
FILING NUMBER

I, CARL F. ROSER, do hereby certify that under requirements of P.A. 74, Michigan P.A. of 1970, the corner points mentioned in lines 1 and 2 above were, in a field survey on JANUARY 11, 1983, established, re-established, monumented, re-monumented, recovered or restored as expressed below and in conformance with regulations and rules therefore as required in the current manual of survey instructions of the United States Department of the Interior, Bureau of Land Management or by a decree of a court of law. Furthermore, that the corner points mentioned in lines 3, 4 and 5 above were, in a field survey on \_\_\_\_\_, 19\_\_\_\_, found, recovered, restored, established or re-established as expressed below and in conformance with the rules of the Michigan State Board of Registration for Land Surveyors or, by a Decree of a Court of law:

B. CONTINUED:

- 13 - CONTINUED; MARKS STILL EVIDENT), S13°E, 37.0' & W.P. STUMP N42 1/2° W, 4.6' (SEE CAUKINS FIELD NOTES: PG. 42, AT ANTRIM CO. RD. COMM.)

B. Description of corner evidence found and/or method applied in restoring or re-establishing corner:

- 14 - RECOVERED SOUTH 1/8 COR ON EAST LINE OF SEC 20 PER B.L. CAUKINS. RETRACEMENT & BDRY. SURVEY, DATED MAY 1920 (SEE HIS FIELD NOTES PG'S 38 & 39 AT ANTRIM CO. ROAD COMM.). FD DEFIN. 4" PINE POST BOTTOM (0.5' TO 2' DEEP) FROM CAUKIN'S B.T. STUMPS; W.P. STUMP 24", S08°E, 24.4' & Y.P. STUMP 16" (SCRIBE MARKS STILL EVIDENT), N49 1/2°E, 48.2'. A N-S TRAIL ROAD (NEW RD) IS 27'± EAST.
- 13 - FD 1/2" X 18" REROD FOR CTR OF SE 1/4 OF SEC 20 (BELIEVED TO BE BY RLS, J. FLETCHER) AT SE COR OF 4" SQ. PINE POST BOTTOM. POST BOTTOM FITS B.L. CAUKINS JUNE, 1920 SURVEY & B.T. STUMPS; W.P. STUMP 30" (SCRIBE

C. Description of monument for corner and accessories established to perpetuate locating the position of the corner:

<u>14</u>	<u>13</u>
FD CAUKINS POST BOTTOM & DROVE	FD 1/2" REROD; REPLACED WITH 5/8" X 36"
5/8" X 36" REROD W/RLS CAP &	REROD W/RLS CAP & SET CEDAR POST W/LOC
SET CEDAR POST W/LOC TAG	TAG
* 6" MAPLE N56°W 28.5	* 6" MAPLE CLUSTER N56°W 21.1
* 9" MAPLE N06°E 37.0	* 5" TWN IRONWOOD N46°E 17.6
* 5" MAPLE CLUSTER S24°E 19.8	8" TRP. MAPLE S80°E 41.0
FD RLS J. FLETCHER S00°32'E 9.59	NW COR OF N 40 RODS
1/2" ROD	OF S 80 RODS OF GOV'T S00°39'W 29.88
* = OLD WIT. BY OTHERS	LOT 5, SEC 20, SET 5/8" X 36" REROD

SIGNED BY Carl F. Roser 05-02-83 DATE

SURVEYOR'S MICHIGAN REGISTRATION NO. 12028


FOR STATE AND UNITED STATES AGENCIES:

SIGNED BY \_\_\_\_\_ DATE \_\_\_\_\_

CHIEF OF SURVEY PARTY

APPROVED AND SIGNED BY \_\_\_\_\_ DATE \_\_\_\_\_

MICHIGAN REGISTERED LAND SURVEYOR

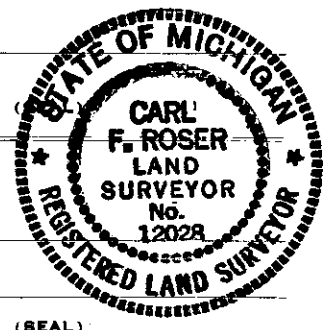

(SEAL)

SURVEYOR'S MICHIGAN REGISTRATION NO. \_\_\_\_\_

BLUE LAKE, Twp.  
KALKASKA COUNTY