

SURVEY & REMONUMENTATION

MAR 03 1998

KENT COUNTY REMONUMENTATION

LAND CORNER RECORDATION CERTIFICATE Filing Requirement of Act 74, Mich. P.A. 1970

For corners in SECTION

KENT COUNTY

(County)

Located In:

Corner Code #

1. Public Land Survey

T___ R___
T___ R___
T___ R___
T___ R___

2. Property Controlling
in Section

S36 T5N R9W

Wit. Mon. on
S. Sec. line
(for L-13)

3. Miscellaneous
Property in Sec.

S___ T___ R___
S___ T___ R___

4. Lot No. _____, Recorded Plat _____
5. Private Claims _____

I, Kirk Breitels, in a field survey on Feb. 7, 1997 do hereby state that under requirements of P.A. 74, Michigan P.A. of 1970, the corner points mentioned in lines 1 and 2 above were in conformance with regulations and rules therefore as required in the current manual of survey instructions of the United States Department of the Interior, Bureau of Land Management or by a decree of a Court of Law and/or that the corner points mentioned in lines 3, 4 and 5 above were in conformance with the rules of the Michigan Board of Land Surveyors or by a Decree of a Court of Law; established, re-established, monumented, recovered, found as expressed below:

NOTE: Not more than 2 corners, all in the same town and range, may be recorded on this certificate.

A. Description of original monument and accessories and/or subsequent restoration:

1830	GLO	Mullett	Set Post at 1/4 corner
1965	Kent Co. Wit.		1/2" Iron
1980	LCRC #1391	Herrema	1/2" Solid Iron
1984	CETA		Set Witness Monument
1991	LCRC #5866	Hubers	Found Witness Monument

The position of this corner was previously approved by the Kent County Remonumentation Peer Group, witness monument set, and recorded by Harvey Hubers on 6/11/91, recorded per LCRC #5866.

B. Description of corner evidence found and/or method applied in restoring or reestablishing corner:


Found Harrison Monument with witness cap per witnesses from above LCRC as recorded by Harvey Hubers (set by CETA). Monument is on Sec. line per previous surveys.
LCRC #5866

Nail & KC Remon. tag N. side 16" Elm	East	19.65'	Westerly bank of
Nail & KC Remon. tag W. side 20" Elm	S15°W	8.87'	Coldwater River is
Nail & KC Remon. tag W. side 10" Elm	North	30.17'	East 55'±
Nail & KC Remon. tag W. side 8" Elm	N30°W	12.46'	
Nail & KC Remon. tag E. side 8" Elm	S35°W	22.53'	
Solid Iron at edge of river is	East	45.45' (Meas. ±)	

The selected location is accepted by me and is generally accepted by professional surveyors as the best available evidence of the position of the corner.

C. Description of monument for corner and accessories established to perpetuate locating the position of the corner:

Harrison Monument with witness cap			
Nail & KC Remon. tag N. side 22" Elm	S80°E	19.68'	
Nail & KC Remon. tag W. side 24" Elm	S10°W	8.77'	
Nail & KC Remon. tag W. side 10" dead Elm	N05°W	30.17'	
Nail & KC Remon. tag W. side 8" Elm	N30°W	12.46'	
Nail & KC Remon. tag E. side 12" Elm	S15°W	22.53'	
Westerly bank of Coldwater River	East	45'±	

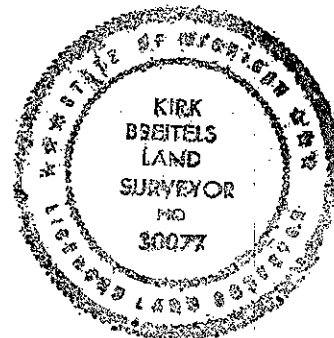

Signed by Kirk Breitels
Surveyor's Michigan License No. 30077

Date 3/27/97

P.A. 345 1990 KENT COUNTY

PEER APPROVED 3/27/97

CHAIRMAN Harvey Hubers

FORM APPROVED BY MICHIGAN STATE BOARD OF PROFESSIONAL SURVEYORS, JAN. 28, 1971
REVISED MAY 14, 1975
REVISED JAN., 1983
REVISED OCT., 1995