

SURVEY &
REMONUMENTATION

FEB 14 1997

LAND CORNER RECORDATION CERTIFICATE
Filing Requirement of Act 74, Mich. P.A. 1970
KENT COUNTY REMONUMENTATION

For corners in COMMISSION

Kent
(County)

Located in: Caledonia Township Corner Code #

1. Public Land Survey T R
T R
T R
T R

2. Property Controlling S 2 T 5N R 10W North Witness
in Section S T R Monument

3. Miscellaneous S T R 1320.7' North of K-3
Property in Sec. S T R

"other" code
4

STATE OF MICHIGAN
COUNTY OF KENT
RECEIVED FOR RECORD
96 NOV -8 AM 9:23
REG. OF DEEDS
9548

Register of Deeds Stamp & File Number

4. Lot No. , Recorded Plat
5. Private Claims

I, Randy Kolehouse, in a field survey on April 9 19 96, do hereby certify that under requirements of P.A. 74 Michigan P.A. of 1970, the corner points mentioned in lines 1 and 2 above were in conformance with regulations and rules therefore as required in the current manual of survey instructions of the United States Department of the interior, Bureau of Land Management or by a decree of a Court of Law and/or that the corner points mentioned in lines 3, 4 and 5 above were in conformance with the rules of the Michigan Board of Land Surveyors or by a Decree of a Court of Law; established, re-established, monumented, re-monumented, recovered, found as expressed below:

NOTE: Not more than 4 corners, all in the same town and range, may be recorded on this certificate.

A. Description of original monument and accessories and/or subsequent restoration:

K-3A	1831	G.L.O. Notes	Mullett	Corner Falls in Lake - Set Temporary Point
	1983	L.C.R.C. #6720	T. Chettleburgh	Fnd. Iron Pipe in Monument Box / Set K.C. Monument
	1995	L.C.R.C. #8132	K. Breitels	K.C. Monument

P.A. 345 1990 KENT COUNTY

PEER APPROVED 8/22/96

CHAIRMAN Randy Kolehouse

This corner was originally approved by the Kent County Remonumentation Peer Group and monumented by T. Chettleburgh on 1/14/93 and was recorded per L.C.R.C. #6720.

B. Description of corner evidence found and/or method applied in restoring or reestablishing corner:

K-3A Found a Standard Kent County Monument 4.1' South of the C/L of 66th Street (bit.) running East and West and 12.0' West of the C/L of a private drive to the South per L.C.R.C.'s #6720 and #8132 as set by T. Chettleburgh in place of a iron pipe he found in a monument box.

L.C.R.C. #6720

Nail/Tag N side 38" Oak S 72° E 68.10'
Nail/Tag E side 14" Pine S 02° W 60.82'
Nail/Tag NW side 18" Oak S 38° W 17.87'
Nail/Tag N side 20" Oak S 79° W 66.14'
Nail/Tag W side 28" Oak N 22° W 29.60'

L.C.R.C. #8132


Nail & KC Remon. tag N. side 42" Oak S 72° E 68.12'
Nail & KC Remon. tag E. side 18" Pine S 02° W 60.82'
Nail & KC Remon. tag NW side 22" Oak S 38° W 17.90' (m. 17.87')
Nail & KC Remon. tag N. side 26" Oak S 79° W 66.14' (m. 66.13')
Nail & KC Remon. tag W. side 30" Oak N 22° W 29.64' (m. 29.60')

The selected location is accepted by me and is generally accepted by professional surveyors as the best available evidence of the position of the original corner.

C. Description of monument for corner and accessories established to perpetuate locating the position of the corner:

K-3A Standard Kent County Monument

Nail & K.C. remon. tag on N side 42" Oak S 72° E 68.12'
Nail & K.C. remon. tag on E side 18" Pine S 02° W 60.82'
Nail & K.C. remon. tag on NW side 22" Oak S 38° W 17.87'
Nail & K.C. remon. tag on N side 26" Oak S 79° W 66.13'
Nail & K.C. remon. tag on W side 30" Oak N 22° W 29.60'
K.C. Mon. @ K-2, T5N, R10W, North 1318.14'

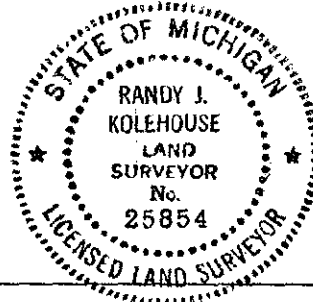

Signed by Randy J. Kolehouse

Date 10/8/96

Surveyor's Michigan License No. 25854