

FEB 14 1997

COMMISSION LAND CORNER RECORDATION CERTIFICATE

Filing Requirement of Act 74, Mich. P.A. 1970

KENT COUNTY REMONUMENTATION

For corners in

<u>Kent</u> (County)	Located in: Caledonia Township	Corner Code #
1. Public Land Survey	T _____ R _____	_____
	T _____ R _____	_____
	T _____ R _____	_____
	T _____ R _____	_____
2. Property Controlling in Section	S <u>12</u> T <u>5N</u> R <u>10W</u>	East Witness Monument
3. Miscellaneous Property in Sec.	S _____ T _____ R _____	1314.32' East of K-3

4. Lot No. \_\_\_\_\_, Recorded Plat \_\_\_\_\_

5. Private Claims \_\_\_\_\_

I, Randy Kolehouse, in a field survey on April 9 19 96, do hereby certify that under requirements of P.A. 74 Michigan P.A. of 1970, the corner points mentioned in lines 1 and 2 above were in conformance with regulations and rules therefore as required in the current manual of survey instructions of the United States Department of the interior, Bureau of Land Management or by a decree of a Court of Law and/or that the corner points mentioned in lines 3, 4 and 5 above were in conformance with the rules of the Michigan Board of Land Surveyors or by a Decree of a Court of Law; established, re-established, monumented, re-monumented, recovered, found as expressed below:

**NOTE:** Not more than 4 corners, all in the same town and range, may be recorded on this certificate.

A. Description of original monument and accessories and/or subsequent restoration:

K-3B	1831	G.L.O. Notes	Mullett	Corner Falls in Lake - Set Temporary Point
	1983	L.C.R.C. #6721	T. Chettleburgh	End. Iron Pipe / Set K.C. Monument
	1995	L.C.R.C. #8133	K. Breitels	K.C. Monument

P.A. 345 1990 KENT COUNTY  
PEER APPROVED 8/22/96  
CHAIRMAN Randy Kolehouse

This corner was originally approved by the Kent County Remonumentation Peer Group and monumented by T. Chettleburgh on 1/14/93 and was recorded per L.C.R.C. #6721.

B. Description of corner evidence found and/or method applied in restoring or reestablishing corner:

K-3B Found a Standard Kent County Monument on the C/L of 68th Street (bit.) running East and West and 5.0' West of the C/L of McCords Avenue (bit.) running North and South per L.C.R.C.'s #6721 and #8133 as set by T. Chettleburgh in place of an iron pipe he found which was above a 2nd iron pipe and stones 0.05' S, 0.06' W, and 0.70' deep.

L.C.R.C. #6721

L.C.R.C. #8133

Nail/Tag SW side Power Pole S 41° E 46.15'  
Nail/Tag E side Tri 18" Maple S 15° W 154.32'  
Nail/Tag N side 26" Oak N 71° W 49.66'  
Nail/Tag NE side 18" Maple N 30° W 58.73'  
1/2" Iron bar East 4.99'  
Centerline N-S bit. road East 5.00'


Nail & KC Remon. tag SW side Power Pole S 41° E 46.17' (m. 46.16')  
Nail & KC Remon. tag E. side Tri. 18" Maple S 15° W 154.40' (m. 154.42')  
Nail & KC Remon. tag N. side 26" Oak N 71° W 49.69' (m. 49.68')  
Nail & KC Remon. tag NE side 18" Maple N 30° W 58.73'  
1/2" Iron bar East 4.99'  
C/L N-S bit. road - East 5.00'

The selected location is accepted by me and is generally accepted by professional surveyors as the best available evidence of the position of the original corner.

C. Description of monument for corner and accessories established to perpetuate locating the position of the corner:

K-3B Standard Kent County Monument

Nail & K.C. remon. tag on SW side P. pole S 41° E 46.16'  
Nail & K.C. remon. tag on E side Tri. 18" Maple S 15° W 154.42'  
Nail & K.C. remon. tag on N side 26" Oak N 71° W 49.68'  
Nail & K.C. remon. tag on N 30° W 58.73'  
1/2" rebar East 4.99'

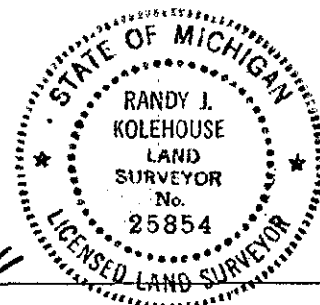

Signed by Randy J. Kolehouse

Date 10/8/96

Surveyor's Michigan License No. 25854