

**SURVEY & REMONUMENTATION**  
\$7.00  
\$2.00 SEP 18 1995

**LAND CORNER RECORDATION CERTIFICATE**  
Filing Requirement of Act 74, Mich. P.A. 1970  
KENT COUNTY REMONUMENTATION

For corners in **COMMISSION**  
Kent  
(County)

Located in:

Corner Code #

- |                                    |             |              |             |
|------------------------------------|-------------|--------------|-------------|
| 1. Public Land Survey              | T <u>5N</u> | R <u>12W</u> | <u>A-13</u> |
|                                    | T _____     | R _____      | _____       |
|                                    | T _____     | R _____      | _____       |
|                                    | T _____     | R _____      | _____       |
| 2. Property Controlling in Section | S _____     | T _____      | R _____     |
|                                    | S _____     | T _____      | R _____     |
| 3. Miscellaneous Property in Sec.  | S _____     | T _____      | R _____     |
|                                    | S _____     | T _____      | R _____     |

STATE OF MICHIGAN  
COUNTY OF KENT  
RECEIVED FOR RECORD  
95 AUG 28 AM 10:47  
REC. OF DEEDS  
*Lucy St. Paul*

8556

Register of Deeds Stamp & File Number

4. Lot No. \_\_\_\_\_, Recorded Plat \_\_\_\_\_  
5. Private Claims \_\_\_\_\_

I, Randy Kolehose, in a field survey on March 14 19 95, do hereby certify that under requirements of P.A. 74 Michigan P.A. of 1970, the corner points mentioned in lines 1 and 2 above were in conformance with regulations and rules therefore as required in the current manual of survey instructions of the United States Department of the interior, Bureau of Land Management or by a decree of a Court of Law and/or that the corner points mentioned in lines 3, 4 and 5 above were in conformance with the rules of the Michigan Board of Land Surveyors or by a Decree of a Court of Law; established, re-established, monumented, re-monumented, recovered, found as expressed below:

**NOTE:** Not more than 4 corners, all in the same town and range, may be recorded on this certificate.

A. Description of original monument and accessories and/or subsequent restoration:

A-13	1817	G.L.O. Notes	L. Lyon	Set Post
	1940's	Wit. Map	K.C. Surveyor	Leaded Stone
	1971	L.C.R.C. #37	Williams & Works	Spike & T Iron
	1980	L.C.R.C. #1509	Williams & Works	Fnd. "T" Iron/Set K.C. Monument
	1988	L.C.R.C. #4634	Olson, Meyers & May	K.C. Monument

P.A. 345 1990 KENT COUNTY

PEER APPROVED 5/25/95

CHAIRMAN *Harry Thibodeau*

This corner was originally approved by the Kent County Remonumentation Peer Group and monumented by Williams & Works on 12/10/80 and was recorded per L.C.R.C. #1509.

B. Description of corner evidence found and/or method applied in restoring or reestablishing corner:

A-13 Found standard Kent County Monument at the Township corner common to T5N R12W, T5N R13W, T4N R12W, T4N R13W, per L.C.R.C.'s #1509 and #4634 as set by Williams & Works in place of a "T" iron they found which checked L.C.R.C. #37.

L.C.R.C. #1509

Nail & K.C. Remon. Tag in West Side 12" Walnut N 20° E 43.73'  
SW Cor. Conc. Hdwl. N 25° W 34.90'  
NE Cor. Hse. Fnd. S 25° W 156.50'  
SE Cor. Conc. Hdwl. N 15° E 33.58'

L.C.R.C. #4634


Nail & K.C. Remon tag in W side 14" Walnut N 20 E 43.73'  
SW cor conc hdwl N 25 W 34.90'  
NE cor hse fndn S 25 W 156.50'  
SE cor conc hdwl N 15 E 33.58'

The selected location is accepted by me and is generally accepted by professional surveyors as the best available evidence of the position of the original corner.

C. Description of monument for corner and accessories established to perpetuate locating the position of the corner:

A-13 Standard Kent County Monument at the Township Corner

Nail & K.C. remon. tag in W side 14" Walnut N 20° E 43.64'  
SW cor. conc. hdwl. N 25° W 34.90'  
SE cor. conc. hdwl. N 15° E 33.58'  
NE cor. hse. fndn. S 25° W 156.50'  
Nail & K.C. remon. tag in SE side P. pole N 68° E 62.44'  
Nail & K.C. remon. tag in W side P. pole S 16° E 79.35'

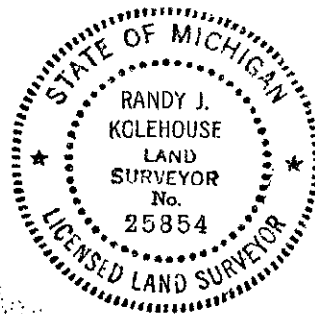

Signed by Randy J. Kolehose  
EARTH TECH

Date 8/21/95

Surveyor's Michigan License No. 25854