

\$7.00  
\$2.00

SURVEY &  
REMONUMENTATION

SEP 18 1995

LAND CORNER RECORDATION CERTIFICATE  
Filing Requirement of Act 74, Mich. P.A. 1970  
KENT COUNTY REMONUMENTATION

For corners in **COMMISSION**

Kent  
(County)

Located in:

Corner Code #

1. Public Land Survey

T 5N R 12W

B-3

T \_\_\_\_\_ R \_\_\_\_\_

T \_\_\_\_\_ R \_\_\_\_\_

T \_\_\_\_\_ R \_\_\_\_\_

2. Property Controlling  
in Section

S \_\_\_\_\_ T \_\_\_\_\_ R \_\_\_\_\_

S \_\_\_\_\_ T \_\_\_\_\_ R \_\_\_\_\_

3. Miscellaneous

S \_\_\_\_\_ T \_\_\_\_\_ R \_\_\_\_\_

Property in Sec.

S \_\_\_\_\_ T \_\_\_\_\_ R \_\_\_\_\_

4. Lot No. \_\_\_\_\_, Recorded Plat \_\_\_\_\_

5. Private Claims \_\_\_\_\_

I, Randy Kolehose, in a field survey on March 15 19 95, do hereby certify that under requirements of P.A. 74 Michigan P.A. of 1970, the corner points mentioned in lines 1 and 2 above were in conformance with regulations and rules therefore as required in the current manual of survey instructions of the United States Department of the interior, Bureau of Land Management or by a decree of a Court of Law and/or that the corner points mentioned in lines 3, 4 and 5 above were in conformance with the rules of the Michigan Board of Land Surveyors or by a Decree of a Court of Law; established, re-established, monumented, re-monumented, recovered, found as expressed below:

NOTE: Not more than 4 corners, all in the same town and range, may be recorded on this certificate.

A. Description of original monument and accessories and/or subsequent restoration:

B-3	1831	G.L.O. Notes	Mullett	Set Post
	1960	Wit. Map	K.C. Surveyor	3/4" Iron
	1971	L.C.R.C. #35	Williams & Works	"T" Iron Over 3/4" Iron
	1981	L.C.R.C. #1558	Nederveld & Jonker	Fnd. "T" Iron Over/Set K.C. Monument
	1988	L.C.R.C. #4664	Olson, Meyers & May	K.C. Monument

P.A. 345 1980 KENT COUNTY

PEER APPROVED 5/25/95

CHAIRMAN Harry H. H.

This corner was originally approved by the Kent County Remonumentation Peer Group and monumented by Nederveld & Jonker on 1/12/81 and was recorded per L.C.R.C. #1558.

B. Description of corner evidence found and/or method applied in restoring or reestablishing corner:

B-3 Found standard Kent County Monument 5' M/L North of the C/L of 68th Street running E-W per L.C.R.C.'s #1558 and #4664 as set by Nederveld & Jonker in place of a "T" iron over a 3/4" iron (down 24") they found which checked L.C.R.C. #35 and K.C. Surveyor's records.

L.C.R.C. #1558

L.C.R.C. #4664

Nail & Remon. tag on E side 14" Hickory S 109.22'  
Nail & Remon. tag on SW side 16" Ash NW 69.58'  
Nail & Remon. tag on E side 12" Ash SSW 56.84'  
Fd. "X" on NW end conc. culv. ENE 83.08'


Nail & Remon. tag on E side 16" Hickory S 0 E 109.22'  
Nail & Remon. tag on SW side 18" Ash N 50 W 69.58'  
Nail & Remon. tag on E side 14" Ash S 15 W 56.84'  
"X" on NW end conc. culvt. N 75 E 83.08'

The selected location is accepted by me and is generally accepted by professional surveyors as the best available evidence of the position of the original corner.

C. Description of monument for corner and accessories established to perpetuate locating the position of the corner:

B-3 Standard Kent County Monument

Nail & K.C. remon. tag in 12" Hickory S 108.75'  
Nail & K.C. remon. tag in E side 16" Hickory S 0° E 109.22'  
Nail & K.C. remon. tag in SW side 18" Ash N 50° W 69.58'  
Nail & K.C. remon. tag in E side 14" Ash S 15° W 56.84'  
"X" on NW end conc. culvert N 75° E 83.08'

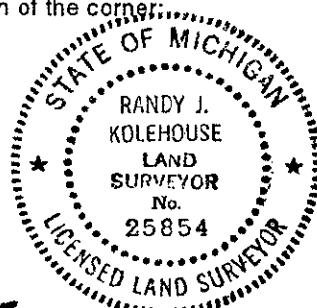

Signed by Randy J. Kolehose

Date 8/21/95

Surveyor's Michigan License No. 25854