

\$7.00
\$2.00

SEP 18 1995

COMMISSION

LAND CORNER RECORDATION CERTIFICATE
Filing Requirement of Act 74, Mich. P.A. 1970
KENT COUNTY REMONUMENTATION

For corners in Kent (County) Located in: _____ Corner Code # _____

1. Public Land Survey T 5N R 12W C-10
 T _____ R _____
 T _____ R _____
 T _____ R _____

2. Property Controlling S _____ T _____ R _____
 in Section S _____ T _____ R _____

3. Miscellaneous S _____ T _____ R _____
 Property in Sec. S _____ T _____ R _____

4. Lot No. _____, Recorded Plat _____

5. Private Claims _____

STATE OF MICHIGAN
COUNTY OF KENT
RECEIVED FOR RECORD

95 AUG 28 AM 10:48

REG. OF DEEDS
[Signature]
8573

Register of Deeds Stamp & File Number


I, Randy Kolehouse, in a field survey on March 14 19 95, do hereby certify that under requirements of P.A. 74 Michigan P.A. of 1970, the corner points mentioned in lines 1 and 2 above were in conformance with regulations and rules therefore as required in the current manual of survey instructions of the United States Department of the Interior, Bureau of Land Management or by a decree of a Court of Law and/or that the corner points mentioned in lines 3, 4 and 5 above were in conformance with the rules of the Michigan Board of Land Surveyors or by a Decree of a Court of Law; established, re-established, monumented, re-monumented, recovered, found as expressed below:

NOTE: Not more than 4 corners, all in the same town and range, may be recorded on this certificate.

A. Description of original monument and accessories and/or subsequent restoration:

C-10	1831	G.L.O. Notes	Mullett	Set Post
	1940's	Wit. Map	K.C. Surveyor	Leaded Stone
	1973	L.C.R.C. #366	Clapp	1" Iron Pipe
	1977	L.C.R.C. #1035	Moore & Bruggink	3/4" Iron
	1981	L.C.R.C. #1572	Nederveld & Jonker	Fnd. Iron Pipe/Set K.C. Monument
	1988	L.C.R.C. #4623	Olson, Meyers & May	K.C. Monument

P.A. 345 1930 KENT COUNTY
PEER APPROVED 5/25/95
CHAIRMAN [Signature]

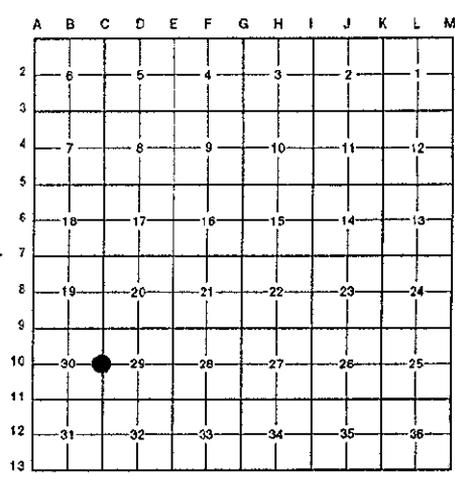

This corner was originally approved by the Kent County Remonumentation Peer Group and monumented by Nederveld & Jonker on 1/12/81 and was recorded per L.C.R.C. #1572.

B. Description of corner evidence found and/or method applied in restoring or reestablishing corner:

C-10 Found standard Kent County Monument 7' M/L East of the C/L of Wilson Avenue running N-S on line of tree row running East and 12' M/L North of tree row running West per L.C.R.C.'s #1572 and #4623 as set by Nederveld & Jonker in place of an iron pipe they found which checked L.C.R.C.'s #366 and #1035.

L.C.R.C. #1572

- Nail & remon. tag on N side 36" maple WNW 48.3'
- Nail & remon. tag on N side 26" maple NW 57.0'
- Nail & remon. tag on N side 13" maple East 17.69'
- Nail & remon. tag on SE side 6" tw. Elm S.W. 35.25'

L.C.R.C. #4623


- Nail & remon tag on N sde 38" Mapie N 75 W 48.27'
- Set Nail & Remon tag on N sde 28" Maple N 55 W 56.96'
- Nail & Remon tag on N sde 15" Maple S 90 E 17.75'
- Set nail & Remon tag on SE sde 8" twin Elm S 55 W 35.12'

The selected location is accepted by me and is generally accepted by professional surveyors as the best available evidence of the position of the original corner.

C. Description of monument for corner and accessories established to perpetuate locating the position of the corner:

C-10 Standard Kent County Monument

- Nail & K.C. remon. tag on N side 40" Maple N 75° W 48.27'
- Nail & K.C. remon. tag on N side 30" Maple N 55° W 56.96'
- Nail & K.C. remon. tag on N side 18" Maple S 90° E 17.75'
- Nail & K.C. remon. tag on SE side 10" Twin Elm S 55° W 35.53'
- C/L of Wilson Avenue West 7' M/L

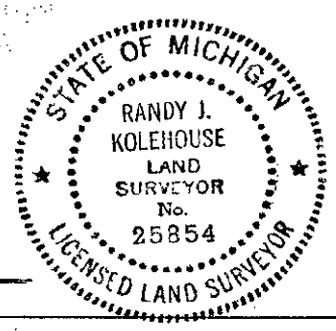

Signed by Randy J. Kolehouse Date 8/21/95
EARTH TECH

Surveyor's Michigan License No. 25854