

\$7.00 SEP 18 1995  
\$2.00 COMMISSION

LAND CORNER RECORDATION CERTIFICATE  
Filing Requirement of Act 74, Mich. P.A. 1970  
KENT COUNTY REMONUMENTATION

For corners in

Kent  
(County)

Located in:

Corner Code #

1. Public Land Survey T 5N R 12W C-13  
T      R       
T      R       
T      R
2. Property Controlling S      T      R       
in Section S      T      R
3. Miscellaneous S      T      R       
Property in Sec. S      T      R

4. Lot No.                 , Recorded Plat
5. Private Claims

I, Randy Kolehouse, in a field survey on March 14 19 95, do hereby certify that under requirements of P.A. 74 Michigan P.A. of 1970, the corner points mentioned in lines 1 and 2 above were in conformance with regulations and rules therefore as required in the current manual of survey instructions of the United States Department of the interior, Bureau of Land Management or by a decree of a Court of Law and/or that the corner points mentioned in lines 3, 4 and 5 above were in conformance with the rules of the Michigan Board of Land Surveyors or by a Decree of a Court of Law; established, re-established, monumented, re-monumented, recovered, found as expressed below:

NOTE: Not more than 4 corners, all in the same town and range, may be recorded on this certificate.

A. Description of original monument and accessories and/or subsequent restoration:

C-13	1817	G.L.O. Notes	L. Lyon	Set Post	P.A. 345 1990 KENT COUNTY
	1940's	Wit. Map	K.C. Surveyor	Leaded Stone	PEER APPROVED <u>5/25/95</u>
	1961	Wit. Map	K.C. Surveyor	Leaded Stone	CHAIRMAN <u>Harry Huber</u>
	1972	L.C.R.C. #1306	Nederveld & Jonker	1/2" Solid Iron	
	1980	L.C.R.C. ##1574	Nederveld & Jonker	Fnd. 1/2" Iron Over Stone/Set K.C. Monument	
	1988	L.C.R.C. #4643	Olson, Meyers & May	K.C. Monument	

This corner was originally approved by the Kent County Remonumentation Peer Group and monumented by Nederveld & Jonker on 12/31/80 and was recorded per L.C.R.C. #1574.

B. Description of corner evidence found and/or method applied in restoring or reestablishing corner:

C-13 Found standard Kent County Monument 6' M/L East of the C/L of Wilson Avenue running N-S and 1' M/L North of the C/L of 108th Street running E-W per L.C.R.C.'s #1574 and #4643 as set by Nederveld & Jonker in place of a 1/2" solid iron over a 16" x 24" leaded stone (12" below grade) they found which checked L.C.R.C. #1306 and the K.C. Surveyor's records.

L.C.R.C. #1574

Nail & Remon. tag on SW side P. pole SSE 37.16'  
Nail & Remon. tag on NW side P. pole SW 46.65'  
Nail & Remon. tag on NE side P. pole NW 43.5'  
SW cor. bldg. NE 62.95'  
NW cor. bldg. NNE 91.35'

L.C.R.C. #4643

Nail & Remon tag on SW sde P pole S 30° E 37.16'  
Nail & Remon tag on NW sde P pole S 60° W 46.65'  
Nail & Remon tag on NE sde P pole N 50° W 43.5'  
SW cor bldg N 40° E 62.95'

The selected location is accepted by me and is generally accepted by professional surveyors as the best available evidence of the position of the original corner.

C. Description of monument for corner and accessories established to perpetuate locating the position of the corner:

C-13 Standard Kent County Monument

Nail & K.C. remon. tag on SW side P. pole S 30° E 37.16'  
Nail & K.C. remon. tag on NW side P. pole S 60° W 46.65'  
Nail & K.C. remon. tag on NE side P. pole N 50° W 43.18'  
SW cor. bldg. N 40° E 62.95'  
NW cor. bldg. N 35° E 91.35'

Signed by Randy J. Kolehouse  
EARTH TECH


Date 8/21/95

Surveyor's Michigan License No. 25854

STATE OF MICHIGAN  
COUNTY OF KENT  
RECEIVED FOR RECORD  
95 AUG 28 AM 10:48  
REG. OF DEEDS

8576

Register of Deeds Stamp & File Number

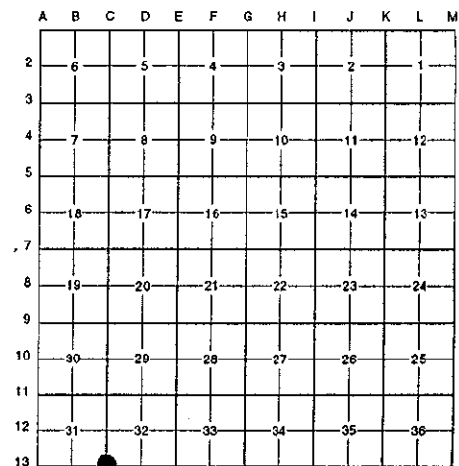

P.A. 345 1990 KENT COUNTY  
PEER APPROVED 5/25/95  
CHAIRMAN Harry Huber

