

SEP 18 1995

COMMISSION

LAND CORNER RECORDATION CERTIFICATE
Filing Requirement of Act 74, Mich. P.A. 1970
KENT COUNTY REMONUMENTATION

For corners in

Kent
(County)

Located in:

Corner Code #

- | | | | |
|------------------------------------|-------------|--------------|-------------|
| 1. Public Land Survey | T <u>5N</u> | R <u>12W</u> | <u>D-13</u> |
| | T | R | |
| | T | R | |
| | T | R | |
| 2. Property Controlling in Section | S | T | R |
| | S | T | R |
| 3. Miscellaneous Property in Sec. | S | T | R |
| | S | T | R |

REG. OF DEEDS

W. J. K. Colehouse

95 AUG 28 AM 10:49

STATE OF MICHIGAN
COUNTY OF KENT
RECEIVED FOR RECORD

8583

Register of Deeds Stamp & File Number

4. Lot No. _____, Recorded Plat _____
5. Private Claims _____

I, Randy Kolehouse, in a field survey on April 11 19 95, do hereby certify that under requirements of P.A. 74 Michigan P.A. of 1970, the corner points mentioned in lines 1 and 2 above were in conformance with regulations and rules therefore as required in the current manual of survey instructions of the United States Department of the Interior, Bureau of Land Management or by a decree of a Court of Law and/or that the corner points mentioned in lines 3, 4 and 5 above were in conformance with the rules of the Michigan Board of Land Surveyors or by a Decree of a Court of Law; established, re-established, monumented, re-monumented, recovered, found as expressed below:

NOTE: Not more than 4 corners, all in the same town and range, may be recorded on this certificate.

A. Description of original monument and accessories and/or subsequent restoration:

D-13	1817	G.L.O. Notes	L. Lyon	Set Post
	1979	L.C.R.C. #1306	Nederveld & Jonker	Found "T" Iron
	1981	L.C.R.C. #1577	Nederveld & Jonker	Found "T" Iron/Set K.C. Monument
	1988	L.C.R.C. #4613	Olson, Meyers & May	K.C. Monument

P.A. 345 1990 KENT COUNTY

PEER APPROVED 6/27/99
CHAIRMAN Harry Huber

This corner was originally approved by the Kent County Remonumentation Peer Group and monumented by Nederveld & Jonker on 1/21/81 and was recorded per L.C.R.C. #1577.

B. Description of corner evidence found and/or method applied in restoring or reestablishing corner:

D-13 Found standard Kent County Monument 3' East of C/L of Homerich Avenue running N-S and 2' South of C/L of 108th Street running E-W per L.C.R.C.'s #1577 and #4613 as set by Nederveld & Jonker in place of a "T" iron they found which checked L.C.R.C. #1306 and Consumers Power Company Witness.

L.C.R.C. #1577

L.C.R.C. #4613

Nail & Remon. tag on E side 20" Maple SSE 79.55'
Nail & Remon. tag on E side 28" Chestnut SSW 70.65'


Nail & Remon tag on E side 22" Maple S 15 E 79.55'
Nail & Remon tag on E side 30" Chestnut S 30 W 70.65'
Top C/L Tel. Box #3599 N 50 E 43.91'
Top C/L M.B.T. Box N 50 W 57.62'

The selected location is accepted by me and is generally accepted by professional surveyors as the best available evidence of the position of the original corner.

C. Description of monument for corner and accessories established to perpetuate locating the position of the corner:

D-13 Standard Kent County Monument

Nail & K.C. remon. tag on E side 22" Maple S 15° E 79.55'
Nail & K.C. remon. tag on E side 30" Chestnut S 30° W 70.55'
Top MBT box N 50° E 43.77'
Top MBT box N 50 W 57.50'
Nail & K.C. remon. tag on W side 8" Maple N 22° E 101.35'
Nail & K.C. remon. tag on N side 10" Maple S 60° E 71.70'

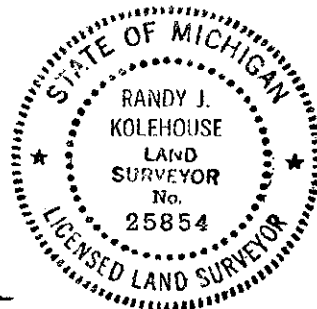

Signed by Randy J. Kolehouse

Date 8/21/95

EARTH TECH

Surveyor's Michigan License No. 25854