

\$7.00 SEP 1 3 1995
\$2.00 COMMISSION

LAND CORNER RECORDATION CERTIFICATE
Filing Requirement of Act 74, Mich. P.A. 1970
KENT COUNTY REMONUMENTATION

For corners in

Kent (County)	Located in:	Corner Code #
1. Public Land Survey	T <u>5N</u> R <u>12W</u>	<u>E-9</u>
	T _____ R _____	_____
	T _____ R _____	_____
	T _____ R _____	_____
2. Property Controlling in Section	S _____ T _____	_____
	S _____ T _____	_____
3. Miscellaneous Property in Sec.	S _____ T _____	_____
	S _____ T _____	_____

STATE OF MICHIGAN
COUNTY OF KENT
RECEIVED FOR RECORD
95 AUG 28 AM 10:50
REG. OF DEEDS
8592

Register of Deeds Stamp & File Number

4. Lot No. _____, Recorded Plat _____
5. Private Claims _____

I, Randy Kolehouse, in a field survey on April 11 19 95,
do hereby certify that under requirements of P.A. 74 Michigan P.A. of 1970, the corner points
mentioned in lines 1 and 2 above were in conformance with regulations and rules therefore as required
in the current manual of survey instructions of the United States Department of the interior, Bureau of
Land Management or by a decree of a Court of Law and/or that the corner points mentioned in lines 3,
4 and 5 above were in conformance with the rules of the Michigan Board of Land Surveyors or by a
Decree of a Court of Law; established, re-established, monumented, re-monumented, recovered,
found as expressed below:

NOTE: Not more than 4 corners, all in the same town and range, may be recorded
on this certificate.

A. Description of original monument and accessories and/or subsequent restoration:

E-9	1831	G.L.O. Notes	Mullett	Set Post	P.A. 345 1990 KENT COUNTY
	1935	Wit. Map	K.C. Surveyor	1" Iron	PEER APPROVED 5/25/95
	1964	Wit. Map	K.C. Surveyor	Monument Box	CHAIRMAN <u>Randy Kolehouse</u>
	1974	L.C.R.C. #703	Exxel Engineering	Found 3/4" Iron in Mon. Box	
	1980	L.C.R.C. #1579	Nederveld & Jonker	Found 3/4" Iron in Mon. Box/Set K.C. Monument	
	1988	L.C.R.C. #4649	Olson, Meyers & May	K.C. Monument	

This corner was originally approved by the Kent County Remonumentation Peer Group and monumented by Nederveld &
Jonker on 12/18/80 and was recorded per L.C.R.C. #1579.

B. Description of corner evidence found and/or method applied in restoring or reestablishing corner:

E-9 Found standard Kent County Monument in a monument box at the C/L intersection of 92nd running E-W and Ivanrest running
South per L.C.R.C.'s #703, #1579 and #4649 as set by Nederveld & Jonker in place of a 3/4" iron in monument box they
found which checked L.C.R.C. #703 and K.C. Surveyor's Wit. Map (1964).

L.C.R.C. #1579

NW corner brick garage SE 100.79'
SE corner hse (porch) NW 109.7'
Most Easterly cor. C.B. rim SW 45.93'

L.C.R.C. #4649


NW cor brick garage S 40° E 100.79'
SE cor conc fndn hse (porch) S 55° E 109.7'
Most E'ly cor C.B. rim S 60° W 45.93'
Nail & K.C. Remon tag in E sde P pole S 30° E 62.64'

The selected location is accepted by me and is generally accepted by professional surveyors as the best available evidence
of the position of the original corner.

C. Description of monument for corner and accessories established to perpetuate locating the position of the corner:

E-9 Standard Kent County Monument in a Monument Box

NW cor. brick garage S 40° E 100.79'
SE cor. conc. fndn. hse. (porch) N 55° W 109.85'
Most E'ly cor. C.B. rim (NE cor.) S 60° W 45.93'
Nail & K.C. remon. tag on E side P. pole S 30° E 62.64'
Nail & K.C. remon. tag on N side 30° Maple S 70° E 105.46'

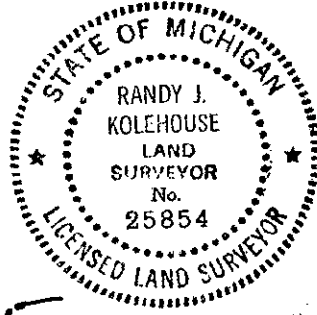

Signed by Randy Kolehouse Date 8/21/95

EARTH TECH

Surveyor's Michigan License No. 25854