

**SURVEY &  
REMONUMENTATION**

APR 27 1995

**COMMISSION**

**LAND CORNER RECORDATION CERTIFICATE**  
Filing Requirement of Act 74, Mich. P.A. 1970

STATE OF MICHIGAN  
COUNTY OF KENT  
RECEIVED FOR RECORD

94 DEC 28 PM 2:15

REG. OF DEEDS

7924

Register of Deeds Stamp & File Number

For corners in

Kent  
(County)

Located In:

Corner Code #

1. Public Land Survey T 5N R 12W F-8  
T R  
T R  
T R
2. Property Controlling S T R  
in Section S T R  
3. Miscellaneous S T R  
Property in Sec. S T R
4. Lot No. , Recorded Plat  
5. Private Claims

I, Douglas W. Bonnema, in a field survey on Nov. 11, 19 94,  
do hereby certify that under requirements of P.A. 74, Michigan P.A. of 1970, the corner points mentioned  
in lines 1 and 2 above were in conformance with regulations and rules therefore as required in the  
current manual of survey instructions of the United States Department of the Interior, Bureau of Land  
Management or by a decree of a Court of Law and/or that the corner points mentioned in lines 3, 4 and 5  
above were in conformance with the rules of the Michigan Board of Land Surveyors or by a Decree of a  
Court of Law; established, re-established, monumented, re-monumented, recovered, found as  
expressed below:

**NOTE: Not more than 4 corners, all in the same town and range, may be recorded  
on this certificate.**

**A. Description of original monument and accessories and/or subsequent restoration:**

Since this is not a government corner there is no G.L.O. information.

Williams & Works 1951 to 1958 Used fence corner Medema VanKooten 1960's & 1970's  
Set iron and later plat monument at  
true position.  
Exxel Engineering also used & witnessed.  
Nail in W sde 26" Beech S-SW 8.85'  
Nail in S sde 30" W. Cherry E-SE 13.36'  
Nail in E sde 14" Cherry N-NE 28.58'

**B. Description of corner evidence found and/or method applied in restoring or reestablishing corner:**

Found plat monument per previous Exxel Engineering witnesses.

We calculate the monument is 1.1'± North and 0.1'± West of the intersection  
of the 1/4 lines.

The selected location is accepted by me and is generally accepted by professional  
surveyors as the best available evidence of the position of the corner.


P.A. 345 1990 KENT COUNTY

PEER APPROVED

CHAIRMAN

**C. Description of monument for corner and accessories established to perpetuate locating the position of the corner:**

Replaced plat monument with 4" x 30" Kent County Cast Iron Mon.  
Nail & KC tag in S'ly sde 40" W. Cherry S66°E 13.00'  
Nail & KC tag in S'ly sde 10" Maple N62°E 17.49'  
Nail & KC tag in SE sde 30" W. Cherry N35°E 28.47'  
Nail & KC tag in SW sde 30" W. Cherry N24°W 29.66'  
Nail & KC tag in N'ly sde 22" Maple S83°W 19.90'  
Nail & KC tag in W'ly sde 26" Beech S30°W 8.56'  
E-W fence South 9'

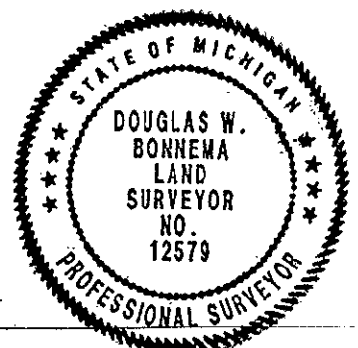

Signed by

Douglas W. Bonnema

Date

12/14/94

Surveyor's Michigan License No.

12579