

SEP 13 1995
COMMISSION

LAND CORNER RECORDATION CERTIFICATE
Filing Requirement of Act 74, Mich. P.A. 1970
KENT COUNTY REMONUMENTATION

For corners in

Kent (County)	Located in:	Corner Code #
1. Public Land Survey	T <u>5N</u> R <u>12W</u>	<u>F-13</u>
	T _____ R _____	_____
	T _____ R _____	_____
	T _____ R _____	_____
2. Property Controlling in Section	S _____ T _____ R _____	_____
	S _____ T _____ R _____	_____
3. Miscellaneous Property in Sec.	S _____ T _____ R _____	_____
	S _____ T _____ R _____	_____

STATE OF MICHIGAN
COUNTY OF KENT
RECEIVED FOR RECORD
95 AUG 28 AM 10:51
REG. OF DEEDS
Randy Kolehous
8603

Register of Deeds Stamp & File Number

- 4. Lot No. _____, Recorded Plat _____
- 5. Private Claims _____


I, Randy Kolehous, in a field survey on April 13 19 95, do hereby certify that under requirements of P.A. 74 Michigan P.A. of 1970, the corner points mentioned in lines 1 and 2 above were in conformance with regulations and rules therefore as required in the current manual of survey instructions of the United States Department of the interior, Bureau of Land Management or by a decree of a Court of Law and/or that the corner points mentioned in lines 3, 4 and 5 above were in conformance with the rules of the Michigan Board of Land Surveyors or by a Decree of a Court of Law; established, re-established, monumented, re-monumented, recovered, found as expressed below:

NOTE: Not more than 4 corners, all in the same town and range, may be recorded on this certificate.

A. Description of original monument and accessories and/or subsequent restoration:

F-13	1817	G.L.O. Notes	L. Lyon	Set Post
	1941	Wit. Map	K.C. Surveyor	Leaded Stone
	1981	L.C.R.C. #2307	Nederveld & Associates	Fnd. 1/2" Iron/Set K.C. Monument
	1986	L.C.R.C. #4427	Jonker	Reset K.C. Monument
	1988	L.C.R.C. #4652	Olson, Meyers & May	K.C. Monument

P.A. 345 1990 KENT COUNTY
PEER APPROVED 5/25/99
CHAIRMAN *Randy Kolehous*

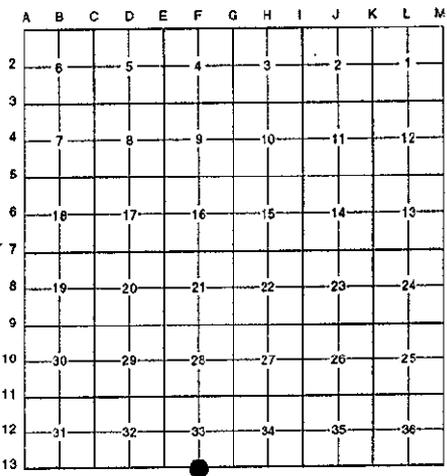

This corner was originally approved by the Kent County Remonumentation Peer Group and monumented by Nederveld Associates on 9/4/81 and was recorded per L.C.R.C. #2307.

B. Description of corner evidence found and/or method applied in restoring or reestablishing corner:

F-13 Found standard Kent County Monument at the C/L intersection of 108th Street running E-W and Westan Avenue running N-S. This point is on the Town line and is common with the N 1/4 corner of Section 4, T4N, R12W, per L.C.R.C.'s #4427 and #4652 as set by Nederveld Associates in place of a 1/2" iron they found which checked K.C. Surveyor Wit. Map.

L.C.R.C. #4427

L.C.R.C. #4652

Remon tag on NE side P & T pole S54°E 48.22'
Remon tag on SW side 30" Ash N60°W 68.38'
N.E. cor. hse. fnd. S70°W 96.65'


Remon tag & nail on NE sde P & T pole S 54 E 48.22'
Remon tag & nail on SW sde 32" Ash N 60 W 68.38'
NE cor hse fndn S 70 W 96.65'

The selected location is accepted by me and is generally accepted by professional surveyors as the best available evidence of the position of the original corner.

C. Description of monument for corner and accessories established to perpetuate locating the position of the corner:

F-13 Standard Kent County Monument

- NE cor. hse. fndn. S 70° W 96.65'
- Nail & K.C. remon. tag on SW side 30" Ash N 60° W 68.38'
- Nail & K.C. remon. tag on NE side P. & T. pole S 54° E 48.59'
- Nail & K.C. remon. tag on NW side 12" Ash N 18° E 63.02'

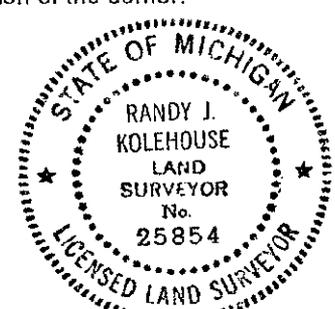

Signed by *Randy J. Kolehous* Date 8/21/95
EARTH TECH

Surveyor's Michigan License No. 25854