

\$2.00  
\$2.00 COMMISSION

SEP 13 1995

**LAND CORNER RECORDATION CERTIFICATE**  
**Filing Requirement of Act 74, Mich. P.A. 1970**  
**KENT COUNTY REMONUMENTATION**

For corners in

Kent  
(County)

Located in:

Corner Code #

- |                                    |             |              |            |
|------------------------------------|-------------|--------------|------------|
| 1. Public Land Survey              | T <u>5N</u> | R <u>12W</u> | <u>G-5</u> |
|                                    | T           | R            |            |
|                                    | T           | R            |            |
|                                    | T           | R            |            |
| 2. Property Controlling in Section | S           | T            | R          |
|                                    | S           | T            | R          |
| 3. Miscellaneous                   | S           | T            | R          |
| Property in Sec.                   | S           | T            | R          |

REC. OF DEEDS

8608

Register of Deeds Stamp &amp; File Number

95 AUG 28 AM 10:51

STATE OF MICHIGAN  
COUNTY OF KENT  
RECEIVED FOR RECORD

4. Lot No. \_\_\_\_\_, Recorded Plat \_\_\_\_\_  
5. Private Claims \_\_\_\_\_

I, Randy Kolehouse, in a field survey on April 12 19 95, do hereby certify that under requirements of P.A. 74 Michigan P.A. of 1970, the corner points mentioned in lines 1 and 2 above were in conformance with regulations and rules therefore as required in the current manual of survey instructions of the United States Department of the interior, Bureau of Land Management or by a decree of a Court of Law and/or that the corner points mentioned in lines 3, 4 and 5 above were in conformance with the rules of the Michigan Board of Land Surveyors or by a Decree of a Court of Law; established, re-established, monumented, re-monumented, recovered, found as expressed below:

**NOTE: Not more than 4 corners, all in the same town and range, may be recorded on this certificate.**

A. Description of original monument and accessories and/or subsequent restoration:

G-5	1831	G.L.O. Notes	Mullett	Set Post
	1965	Wit. Map	K.C. Surveyor	Monument Box
	1971	L.C.R.C. #38	Williams & Works	Found 1" Iron in Mon. Box
	1980	L.C.R.C. #1532	Exxel Engineering	Found 1" Iron in Mon. Box/Set K.C. Monument
	1988	L.C.R.C. #4608	Olson, Meyers & May	K.C. Monument in Mon. Box

P.A. 345 1990 KENT COUNTY

PEER APPROVED 5/27/95

CHAIRMAN Randy Kolehouse

This corner was originally approved by the Kent County Remonumentation Peer Group and monumented by Exxel Engineering on 12/1/80 and was recorded per L.C.R.C. #1532.

B. Description of corner evidence found and/or method applied in restoring or reestablishing corner:

G-5 Found standard Kent County Monument in C/L intersection of 76th Street running E-W and Byron Center Avenue running N-S per L.C.R.C.'s #1532 and #4608 as set by Exxel Engineering in place of a 1" iron in monument box they found which checked L.C.R.C. #38.

L.C.R.C. #1532

SW cor brick church N70°E 191.23'

L.C.R.C. #4608

SW cor brick church N 70 E 191.23'

Nail &amp; K.C. Remon tag in SW sde P pole S 45 W 59.64'

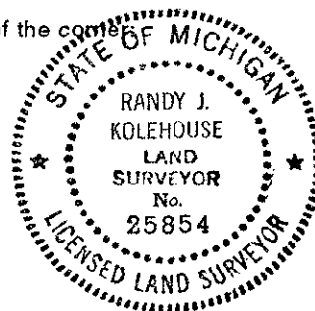
Nail &amp; K.C. Remon tag in SE sde T pole N 55 E 61.69'

The selected location is accepted by me and is generally accepted by professional surveyors as the best available evidence of the position of the original corner.

C. Description of monument for corner and accessories established to perpetuate locating the position of the corner:

G-5 Standard Kent County Monument

Nail & K.C. remon. tag on N face M.B.T. pole N 50° E 61.44'  
SW cor. brick church N 70° E 191.23'  
Nail & K.C. remon. tag on SW side P. pole S 45 W 59.64'  
NE cor. C.B. N 25° W 56.84'  
Nail & K.C. remon. tag on SE side P. pole S 40° W 67.12'


Signed by Randy J. Kolehouse Date 8/21/95

EARTH TECH

Surveyor's Michigan License No. 25854