

# SURVEY & REMONUMENTATION

APR 27 1995

## COMMISSION

### LAND CORNER RECORDATION CERTIFICATE Filing Requirement of Act 74, Mich. P.A. 1970

STATE OF MICHIGAN  
COUNTY OF KENT  
RECEIVED FOR RECORD

94 DEC 28 PM 2:15

REG. OF DEEDS

7915

Register of Deeds Stamp & File Number

For corners in  
Kent

(County)

Located In:

Corner Code #

1. Public Land Survey

T 5N R 12W

H-2

2. Property Controlling  
in Section

S T R

3. Miscellaneous  
Property in Sec.

S T R

4. Lot No. , Recorded Plat

5. Private Claims

I, Douglas W. Bonnema in a field survey on Nov. 10, 19 94,  
do hereby certify that under requirements of P.A. 74, Michigan P.A. of 1970, the corner points mentioned  
in lines 1 and 2 above were in conformance with regulations and rules therefore as required in the  
current manual of survey instructions of the United States Department of the Interior, Bureau of Land  
Management or by a decree of a Court of Law and/or that the corner points mentioned in lines 3, 4 and 5  
above were in conformance with the rules of the Michigan Board of Land Surveyors or by a Decree of a  
Court of Law; established, re-established, monumented, re-monumented, recovered, found as  
expressed below:

**NOTE: Not more than 4 corners, all in the same town and range, may be recorded  
on this certificate.**

#### A. Description of original monument and accessories and/or subsequent restoration:

Since this is not a government corner, there is no G.L.O. information.

Williams & Works 1926 leaded stone  
Williams & Works 1961 T iron in sde of 2" iron  
T.Pole S-SE 42.87'  
14" W. Cherry SE 36.95'  
Spike in E sde P.Pole N 49.70'

P.A. 345 1990 KENT COUNTY

PEER APPROVED 5/26/99

CHAIRMAN [Signature]

#### B. Description of corner evidence found and/or method applied in restoring or reestablishing corner:


Found 1/2" re-rod at surface, found top of bent "T" iron 8" below surface.  
The bottom of "T" iron is inside of 2" pipe, 18" below surface.  
The 2" pipe position is within 0.05' of re-rod at surface.  
No remaining witnesses, however, there is evidence of hole in ground where P.Pole  
had been North 49.5'±.

We calculate the position of this corner is 1.0'± South and 3.3'± East of the  
intersection of the 1/4 lines.

The selected location is accepted by me and is generally accepted by professional  
surveyors as the best available evidence of the position of the corner.

#### C. Description of monument for corner and accessories established to perpetuate locating the position of the corner:

Replaced all of the above markers with a 4" x 30" Kent County Cast Iron Mon.  
Nail & remon tag in W sde P.Pole N08°E 51.60'  
Nail & remon tag in NW sde 6" Pine N52°E 59.78'  
Nail & remon tag in E sde P.Pole S02°E 258.95'  
Nail & remon tag in E sde 14" Elm S05°W 99.36'  
NE corner house fndn. S28°W 303.08'  
C/L of B.T. pavement South 2.1'  
"X" cut on top of conc. culvert S85°W 124.14'

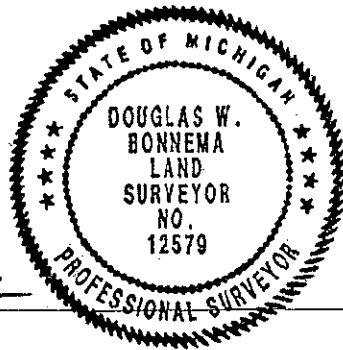

Signed by

Douglas W. Bonnema

Date

12/14/94

12579

Surveyor's Michigan License No.