

LAND CORNER RECORDATION CERTIFICATE
Filing Requirement of Act 74, Mich. P.A. 1970
KENT COUNTY REMONUMENTATION

For corners in

Kent
(County)

Located in:

Corner Code #

1. Public Land Survey

T 5N R 12W

H-3

T

R

T

R

T

R

2. Property Controlling
in Section

S

T

R

S

T

R

3. Miscellaneous
Property in Sec.

S

T

R

S

T

R

4. Lot No. _____, Recorded Plat _____

5. Private Claims _____

I, Randy Kolehouse, in a field survey on April 20 19 95,
do hereby certify that under requirements of P.A. 74 Michigan P.A. of 1970, the corner points
mentioned in lines 1 and 2 above were in conformance with regulations and rules therefore as required
in the current manual of survey instructions of the United States Department of the Interior, Bureau of
Land Management or by a decree of a Court of Law and/or that the corner points mentioned in lines 3,
4 and 5 above were in conformance with the rules of the Michigan Board of Land Surveyors or by a
Decree of a Court of Law; established, re-established, monumented, re-monumented, recovered,
found as expressed below:

NOTE: Not more than 4 corners, all in the same town and range, may be recorded
on this certificate.

A. Description of original monument and accessories and/or subsequent restoration:

H-3	1831	G.L.O. Notes	Mullett	Set Post
	1966	Wit. Map	K.C. Surveyor	Post
	1975	L.C.R.C. #815	Exxel Engineering	Fnd. Steel Fence Post
	1980	L.C.R.C. #1527	Exxel Engineering	Fnd. Steel Fence Post/Set K.C. Monument
	1991	L.C.R.C. #6320	Chris Marshall	K.C. Monument

This corner was originally approved by the Kent County Remonumentation Peer Group and monumented by Exxel Engineering
on 12/4/80 and was recorded per L.C.R.C. #1527.

B. Description of corner evidence found and/or method applied in restoring or reestablishing corner:

H-3 Found standard Kent County Monument at intersection of old fence and tree line running N-S and E-W per L.C.R.C.'s #1527
and #6320 as set by Exxel Engineering in place of a steel fence post they found which checked L.C.R.C. #815 and K.C.
Surveyor's Wit. Map.

L.C.R.C. #1527

L.C.R.C. #6320

Nail and K.C. remon tag (2' above ground) in

S. Sde 12" Elm S85°W 28.58'

Nail & K.C. remon tag (3' above ground) in

NE sde 32" Oak N45°W 84.10'

Nail & Tag S sd 13" Elm N 45 W 84.26'

Nail & Tag W sd 8" Twin Sasafrass S 5 W 14.75'

Nail & Tag S sd 10" W. Cherry S 75° W 36.84'

The selected location is accepted by me and is generally accepted by professional surveyors as the best available evidence
of the position of the original corner.

C. Description of monument for corner and accessories established to perpetuate locating the position of the corner:

H-3 Standard Kent County Monument

Nail & K.C. remon. tag on S side 18" Elm S 85° W 28.85'

Nail & K.C. remon. tag on NE side 36" Oak N 45° W 84.26'

Nail & K.C. remon. tag on W side 8" Twin Sasafrass S 5° W 14.75'

Nail & K.C. remon. tag on S side 10" W. Cherry S 75° W 36.84'

Signed by


Randy J. Kolehouse
EARTH TECH

Date

8/21/95

Surveyor's Michigan License No. 25854

Register of Deeds Stamp & File Number

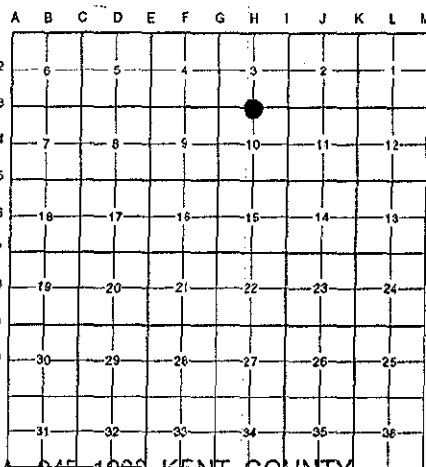

P.A. 545 1990 KENT COUNTY

PEER APPROVED 5/25/95

CHAIRMAN Randy Kolehouse

