

\$7.00
\$2.00

SEP 18 1995

RECORDATION

LAND CORNER RECORDATION CERTIFICATE
Filing Requirement of Act 74, Mich. P.A. 1970
KENT COUNTY REMONUMENTATION

For corners in

Kent
(County)

Located in:

Corner Code #

- | | | | |
|------------------------------------|-------------|--------------|-------------|
| 1. Public Land Survey | T <u>5N</u> | R <u>12W</u> | <u>I-12</u> |
| | T | R | |
| | T | R | |
| | T | R | |
| 2. Property Controlling in Section | S | T | R |
| | S | T | R |
| 3. Miscellaneous Property in Sec. | S | T | R |
| | S | T | R |

STATE OF MICHIGAN
COUNTY OF KENT
RECEIVED FOR RECORD
95 AUG 28 AM 10:53
REG. OF DEEDS
8635

Register of Deeds Stamp & File Number

4. Lot No. _____, Recorded Plat _____
5. Private Claims _____

I, Randy Kolehouse, in a field survey on April 6 19 95, do hereby certify that under requirements of P.A. 74 Michigan P.A. of 1970, the corner points mentioned in lines 1 and 2 above were in conformance with regulations and rules therefore as required in the current manual of survey instructions of the United States Department of the interior, Bureau of Land Management or by a decree of a Court of Law and/or that the corner points mentioned in lines 3, 4 and 5 above were in conformance with the rules of the Michigan Board of Land Surveyors or by a Decree of a Court of Law; established, re-established, monumented, re-monumented, recovered, found as expressed below:

NOTE: Not more than 4 corners, all in the same town and range, may be recorded on this certificate.

A. Description of original monument and accessories and/or subsequent restoration:

I-12	1831	G.L.O. Notes	Mullett	Set Post
	1943	Wit. Map	K.C. Surveyor	1/2" Iron Pipe
	1974	L.C.R.C. #960	Don Ratekin	Found 1/2" Pipe
	1981	L.C.R.C. #2302	Nederveld & Jonker	Found 1/2" Pipe/Set K.C. Monument
	1991	L.C.R.C. #6336	Chris Marschall	K.C. Monument

P.A. 345 1990 KENT COUNTY

PEER APPROVED 5/29/99

CHAIRMAN Harry Huber

This corner was originally approved by the Kent County Remonumentation Peer Group and monumented by Nederveld & Jonker on 9/9/81 and was recorded per L.C.R.C. #2302.

B. Description of corner evidence found and/or method applied in restoring or reestablishing corner:

I-12 Found standard Kent County Monument at the C/L intersection of Burlingame Avenue running N-S and 104th Street running E-W per L.C.R.C.'s #2302 and #6336 as set by Nederveld & Jonker in place of a 1/2" pipe they found which checked L.C.R.C.'s #266 and #960 and K.C. Surveyor's Wit. Map.

L.C.R.C. #2302

L.C.R.C. #6336

Nail & K.C. Remon. tag N side P. pole S70°W 26.89'
Nail & K.C. Remon. tag W side P. pole S30°E 64.82'
Nail & K.C. Remon. tag E side 15" Walnut N40°W 47.93'


Nail & Tag SW side P.P. S 23 E 64.83'
Nail & Tag N side P.P. S 70 W 26.86'
Nail & Tag NE side 24" Walnut N 36 W 47.90'
Nail & Tag E side 20" Ash N 21 W 76.98'

The selected location is accepted by me and is generally accepted by professional surveyors as the best available evidence of the position of the original corner.

C. Description of monument for corner and accessories established to perpetuate locating the position of the corner:

I-12 Standard Kent County Monument

Nail & K.C. remon. tag on SW side P. pole S 23° E 64.83'
Nail & K.C. remon. tag on N side P. pole S 70° W 26.86'
Nail & K.C. remon. tag on NE side 24" Walnut N 36° W 47.90'
Nail & K.C. remon. tag on E side 20" Ash N 21° W 76.98'

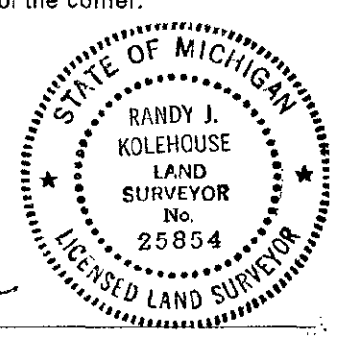

Signed by Randy J. Kolehouse
EARTH TECH

Date 8/21/95

Surveyor's Michigan License No. 25854