

SEP 13 1995

COMMISSION

LAND CORNER RECORDATION CERTIFICATE
Filing Requirement of Act 74, Mich. P.A. 1970
KENT COUNTY REMONUMENTATION

For corners in

Kent (County)

Located in:


Corner Code #

- 1. Public Land Survey T 5N R 12W J-1
2. Property Controlling in Section S T R
3. Miscellaneous Property in Sec. S T R

Register of Deeds Stamp & File Number
8637
95 AUG 28 AM 10:53
STATE OF MICHIGAN
COUNTY OF KENT
RECEIVED FOR RECORD

- 4. Lot No. Recorded Plat
5. Private Claims

I, Randy Kolehouse, in a field survey on April 7, 1995, do hereby certify that under requirements of P.A. 74 Michigan P.A. of 1970, the corner points mentioned in lines 1 and 2 above were in conformance with regulations and rules therefor as required in the current manual of survey instructions of the United States Department of the Interior, Bureau of Land Management or by a decree of a Court of Law and/or that the corner points mentioned in lines 3, 4 and 5 above were in conformance with the rules of the Michigan Board of Land Surveyors or by a Decree of a Court of Law; established, re-established, monumented, re-monumented, recovered, found as expressed below:

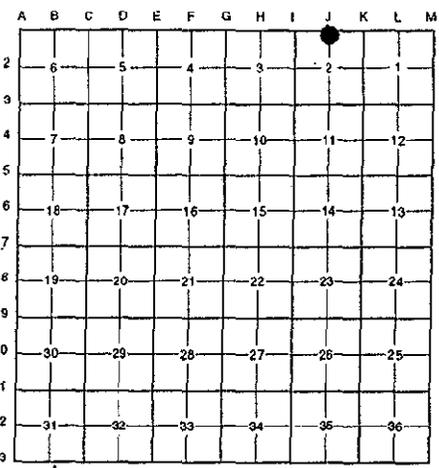

NOTE: Not more than 4 corners, all in the same town and range, may be recorded on this certificate.

A. Description of original monument and accessories and/or subsequent restoration:

Table with 4 columns: Date (1940-1988), Description (Wit. Map, L.C.R.C. #), Surveyor (K.C. Surveyor, Exxel Engineering, M & B, Olson, Meyers & May), and Monument Type (Leaded Stone, Iron, Found 1/2" Iron, Found 3/4" Iron, Found 1/2" Iron/Set K.C. Monument, K.C. Monument). Includes P.A. 345 1990 KENT COUNTY PEER APPROVED 6/27/95 CHAIRMAN [Signature]

This corner was originally approved by the Kent County Remonumentation Peer Group and monumented by Exxel Engineering on 2/20/81 and was recorded per L.C.R.C. #1820.

B. Description of corner evidence found and/or method applied in restoring or reestablishing corner:

J-1 Found standard Kent County Monument on the C/L of 60th Street running E-W and on a tree row running South per L.C.R.C.'s #910, #1820 and #4738 as set by Exxel Engineering in place of a 1/2" Iron they found which checked L.C.R.C.'s #910 and #1053. This point is on the Town line and is 25.82' West of the SW Cor., Sec. 36, T6N R12W.

L.C.R.C. #1820

L.C.R.C. #4738


KC tag in West sde 22" Walnut (2' high) South 149.58'
KC tag in South sde 30" Maple (6" high) N70°W 69.95'

K.C. Mon J-13 (S 1/4 cor 35 6-12) E 25.82'
K.C. tag & nail in W sde 24" Walnut (2' high) S 149.58'
K.C. tag & nail in S sde 32" Maple (6" high) N 70 W 69.95'
K.C. tag & nail in W sde wood fence post N 52 E 33.25'

The selected location is accepted by me and is generally accepted by professional surveyors as the best available evidence of the position of the original corner.

C. Description of monument for corner and accessories established to perpetuate locating the position of the corner:

- J-1 Standard Kent County Monument
Nail & K.C. remon. tag on W side 24" Walnut S 149.58'
Nail & K.C. remon. tag on S side 32" Maple N 70° W 69.95'
Nail & K.C. remon. tag on W side wood fence post N 52° E 33.25'
Nail & K.C. remon. tag on W side P. pole N 35° E 59.38'
K.C. Mon J-13 T6N R12W E 25.82'

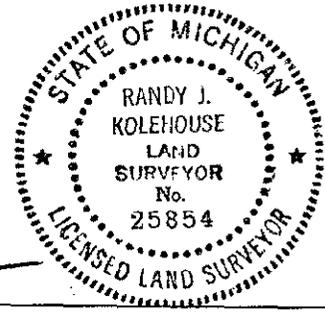

Signed by [Signature] EARTH TECH

Date 8/21/95

Surveyor's Michigan License No. 25854