

SEP 1 9 1995

COMMISSION

LAND CORNER RECORDATION CERTIFICATE

Filing Requirement of Act 74, Mich. P.A. 1970

KENT COUNTY REMONUMENTATION

For corners in

Kent (County)	Located in:	Corner Code #
1. Public Land Survey	T <u>5N</u> R <u>12W</u>	<u>L-5</u>
	T _____ R _____	_____
	T _____ R _____	_____
	T _____ R _____	_____
2. Property Controlling in Section	S _____ T _____ R _____	_____
	S _____ T _____ R _____	_____
3. Miscellaneous Property in Sec.	S _____ T _____ R _____	_____
	S _____ T _____ R _____	_____

4. Lot No. _____, Recorded Plat _____
 5. Private Claims _____

I, Randy Kolehouse, in a field survey on April 4 19 95, do hereby certify that under requirements of P.A. 74 Michigan P.A. of 1970, the corner points mentioned in lines 1 and 2 above were in conformance with regulations and rules therefore as required in the current manual of survey instructions of the United States Department of the interior, Bureau of Land Management or by a decree of a Court of Law and/or that the corner points mentioned in lines 3, 4 and 5 above were in conformance with the rules of the Michigan Board of Land Surveyors or by a Decree of a Court of Law; established, re-established, monumented, re-monumented, recovered, found as expressed below:

NOTE: Not more than 4 corners, all in the same town and range, may be recorded on this certificate.

A. Description of original monument and accessories and/or subsequent restoration:

L-5	1831	G.L.O. Notes	Mullett
	1953	Wit. Map	K.C. Surveyor
	1964	Wit. Map	K.C. Surveyor
	1973	L.C.R.C. #477	Williams & Works
	1980	L.C.R.C. #1525	Exxel Engineering
	1991	L.C.R.C. #6357	Chris Marschall

Set Post
 Iron in Concrete
 1" Iron
 Found 1" Iron in Mon. Box
 Found 1/2" Iron in Mon. Box/Set K.C. Monument
 K.C. Monument

P.A. 345 1990 KENT COUNTY

PEER APPROVED 6/27/95CHAIRMAN Randy Kolehouse

This corner was originally approved by the Kent County Remonumentation Peer Group and monumented by Exxel Engineering on 12/4/80 and was recorded per L.C.R.C. #1525.

B. Description of corner evidence found and/or method applied in restoring or reestablishing corner:

- L-5 Found standard Kent County Monument on the C/L of 76th Street running E-W per L.C.R.C.'s #1525 and #6357 as set by Exxel Engineering in place of 1/2" iron they found in monument box.

L.C.R.C. #1525

L.C.R.C. #6357

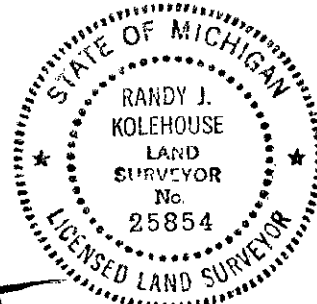
NE cor catchbasin casting S55°W 77.91'
 SE cor catchbasin casting N55°W 78.24'
 Nail & KC remon tag (1' above grade) in W sde
 guy pole N5°E 29.61'

NE cor catchbasin casting S 55 W 77.91'
 SE cor catchbasin casting N 55 W 78.24'
 Nail & Tag W sd Guy Pole N 5 E 29.60'
 PK Nail in top of guard rail post S 30 E 35.41'
 PK Nail in top of guard rail post S 30 W 38.35'
 Section Cor is on centerline of 76th Street
 Section Cor is West of centerline of westerly ramp more or less 230.00'

The selected location is accepted by me and is generally accepted by professional surveyors as the best available evidence of the position of the original corner.

C. Description of monument for corner and accessories established to perpetuate locating the position of the corner:

- L-5 Standard Kent County Monument
 NE cor. catch basin casting S 55° W 77.91'
 SE cor. catch basin casting N 55° W 78.24'
 Nail & K.C. remon. tag on W side Guy pole N 5° E 29.60'
 PK nail in top of guard rail post S 30° E 35.41'
 PK nail in top of guard rail post S 30° W 38.35'

Signed by Randy J. Kolehouse

Date

8/21/95Surveyor's Michigan License No. 25854