

\$7.00  
\$2.00

JAN 23 1996

COMMISSION LAND CORNER RECORDATION CERTIFICATE  
Filing Requirement of Act 74, Mich. P.A. 1970  
KENT COUNTY REMONUMENTATION

Other Code  
# 1

For corners in

Kent (County)	Located in:	Corner Code #
1. Public Land Survey	T <u>5N</u> R <u>12W</u>	<u>Prop Control</u>
	T _____ R _____	Reference Mon.
	T _____ R _____	8.00' North
	T _____ R _____	of F-12
2. Property Controlling in Section	S _____ T _____	
	S _____ T _____	
3. Miscellaneous Property in Sec.	S _____ T _____	
	S _____ T _____	

STATE OF MICHIGAN  
COUNTY OF KENT  
RECEIVED FOR RECORD  
95 DEC 28 PM 2:18  
REG. OF DEEDS  
8888

Register of Deeds Stamp & File Number

4. Lot No. \_\_\_\_\_, Recorded Plat \_\_\_\_\_  
5. Private Claims \_\_\_\_\_

A	B	C	D	E	F	G	H	I	J	K	L	M
2	6	5	4	3	2	1						
3												
4	7	8	9	10	11	12						
5												
6	16	17	18	15	14	13						
7												
8	19	20	21	22	23	24						
9												
10	30	29	28	27	26	25						
11												
12	31	32	33	34	35	36						
13												

I, Randy Kolehose, in a field survey on December 6 19 95,  
do hereby certify that under requirements of P.A. 74 Michigan P.A. of 1970, the corner points  
mentioned in lines 1 and 2 above were in conformance with regulations and rules therefore as required  
in the current manual of survey instructions of the United States Department of the interior, Bureau of  
Land Management or by a decree of a Court of Law and/or that the corner points mentioned in lines 3,  
4 and 5 above were in conformance with the rules of the Michigan Board of Land Surveyors or by a  
Decree of a Court of Law; established, re-established, monumented, re-monumented, recovered,  
found as expressed below:

NOTE: Not more than 4 corners, all in the same town and range, may be recorded  
on this certificate.

A. Description of original monument and accessories and/or subsequent restoration:

F-12 This corner was not originally set by the G.L.O. K.C. wit. map shows an iron at the Center Section. No other record of  
corner.

Witness Map Kent County Surveyor Iron

No other information is on record.

P.A. 345 1990 KENT COUNTY  
PEER APPROVED 8/24/95  
CHAIRMAN Harry Huber

B. Description of corner evidence found and/or method applied in restoring or reestablishing corner:

F-12 This iron indicated on the K.C. wit. map and all wits. have been destroyed due to ditch cleanout. Calculated a point at the  
intersection of 1/4 lines. This point falls in the center line of a 4' wide ditch running East & West and on the approximate  
center line of abandoned road running North & South. Set reference monument on N-S 1/4 line 8.00' North of Center of  
Section.


Meas. N 2692.08' to the N 1/4 corner  
Measure E 2623.92 to the E 1/4 corner  
Measure S 2644.74 to the S 1/4 corner  
Measure W 2652.55' to the W 1/4 corner

The selected location is accepted by me and is generally accepted by professional surveyors as the best available evidence  
of the position of the original corner.

Description of monument for corner and accessories established to perpetuate locating the position of the corner:

F-12 Standard 4" x 30" Kent County Monument. Reference monument 8.00' North of position of F-12. Measure witnesses to  
reference monument.

Nail & K.C. remon. tag in N side 6" Maple N 80° W 62.76'  
Nail & K.C. remon. tag in NW side 6" Elm S 64° W 41.20'  
Nail & K.C. remon. tag in SE side 14" Elm S 44° W 39.45'  
Nail & K.C. remon. tag in E side 8" Elm S 08° E 24.85'

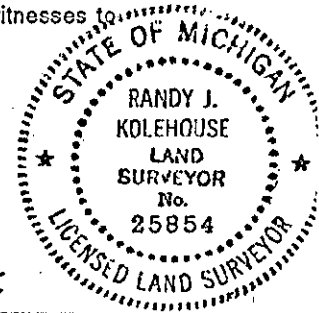

Signed by Randy J. Kolehose  
EARTH TECH

Date 12/22/95

Surveyor's Michigan License No. 25854