

SURVEY & REMONUMENTATION

MAR 03 1998

SECTION

KENT COUNTY REMONUMENTATION

LAND CORNER RECORDATION CERTIFICATE Filing Requirement of Act 74, Mich. P.A. 1970

For corners in
KENT COUNTY

(County)

Located In:

Corner Code #

1. Public Land Survey

T 6N R 9W

C-6

2. Property Controlling
in Section

S

T

3. Miscellaneous
Property in Sec.

S

T

S

T

4. Lot No. , Recorded Plat

5. Private Claims

I, Kirk Breitels

in a field survey on Jan. 30, 1997

do hereby state that under requirements of P.A. 74, Michigan P.A. of 1970, the corner points mentioned in lines 1 and 2 above were in conformance with regulations and rules therefore as required in the current manual of survey instructions of the United States Department of the Interior, Bureau of Land Management or by a decree of a Court of Law and/or that the corner points mentioned in lines 3, 4 and 5 above were in conformance with the rules of the Michigan Board of Land Surveyors or by a Decree of a Court of Law; established, re-established, monumented, recovered, found as expressed below:

NOTE: Not more than 2 corners, all in the same town and range, may be recorded on this certificate.

| | A | B | C | D | E | F | G | H | I | J | K | L | M |
|----|----|---|----|---|----|---|----|---|----|---|----|---|---|
| 1 | | | | | | | | | | | | | |
| 2 | 6 | | 5 | | 4 | | 3 | | 2 | | 1 | | |
| 3 | | | | | | | | | | | | | |
| 4 | 7 | | 8 | | 9 | | 10 | | 11 | | 12 | | |
| 5 | | | | | | | | | | | | | |
| 6 | 18 | | 17 | | 16 | | 15 | | 14 | | 13 | | |
| 7 | | | | | | | | | | | | | |
| 8 | 19 | | 20 | | 21 | | 22 | | 23 | | 24 | | |
| 9 | | | | | | | | | | | | | |
| 10 | 30 | | 29 | | 28 | | 27 | | 26 | | 25 | | |
| 11 | | | | | | | | | | | | | |
| 12 | 31 | | 32 | | 33 | | 34 | | 35 | | 36 | | |
| 13 | | | | | | | | | | | | | |

A. Description of original monument and accessories and/or subsequent restoration:

| | | | | |
|-----|---------|------------------|----------|--------------------------------------|
| C-6 | 1830 | GLO | Mullett | Set Post |
| | 1955-70 | Williams & Works | | Stone-Pile of Stones at fence corner |
| | 1976 | LCRC #1016 | McCombs | "T" Iron at fence cor. |
| | 1985 | LCRC #4144 | Rosema | Set Kent County Monument |
| | 1995 | LCRC #8178 | Breitels | Kent County Monument |

The position of this corner was previously approved by the Kent County Remonumentation Peer Group, monumented by Maurice J. Rosema on 2/14/85 and was recorded per LCRC #4144.

B. Description of corner evidence found and/or method applied in restoring or reestablishing corner:

C-6 Found standard Kent Co. Mon. (Harrison) per witnesses from above LCRC as set by Maurice J. Rosema in place of the "T" Iron he found in a pile of stones. Said "T" Iron checks with Williams & Works information and LCRC # 1016.

LCRC #4144

LCRC #8178

Nail & tag 16" Ash N85°W 32.21'

| | | | | | |
|-------------------------|-------|--------|------------------------|-------|--------|
| Nail & tag 6" Hickory | S05°W | 25.60' | Nail & tag 10" Hickory | S05°W | 25.52' |
| Nail & tag 10" Hickory | S11°E | 26.70' | Nail & tag 12" Hickory | S11°E | 26.73' |
| Nail & tag 12" Ash | S33°E | 19.76' | Nail & tag 15" Ash | S33°E | 19.81' |
| Nail & tag Twin 10" Ash | S85°E | 12.24' | Nail & tag Tw. 12" Ash | S85°E | 12.26' |
| Nail & tag 3" Maple | N12°E | 14.60' | Nail & tag 16" Ash | N12°E | 14.64' |


The selected location is accepted by me and is generally accepted by professional surveyors as the best available evidence of the position of the original corner.

C. Description of monument for corner and accessories established to perpetuate locating the position of the corner:

C-6 Standard Kent County Monument

| | | |
|--|-------|--------|
| Nail & KC Remon. tag E. side 12" Hickory | S05°W | 25.52' |
| Nail & KC Remon. tag W. side 14" Hickory | S11°E | 26.73' |
| Nail & Remon. tag NE side 15" Ash | S33°E | 19.81' |
| Nail & Remon. tag N. side Twin 14" Ash | S85°E | 12.30' |
| Nail & Remon. tag W. side 7" Hickory | N12°E | 14.64' |
| Nail & KC Remon. tag S. side 16" Elm | N85°W | 32.21' |

Fence corner to North & West is North 25'

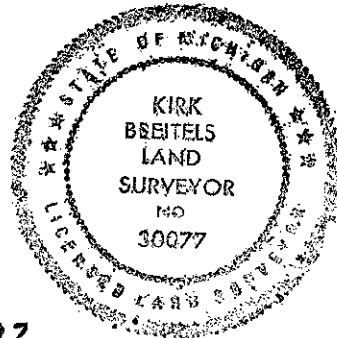

Signed by Kirk Breitels
Surveyor's Michigan License No. 30077

Date 3/27/97

P.A. 345 1990 KENT COUNTY

PEER APPROVED 3/27/97

CHAIRMAN [Signature]

FORM APPROVED BY MICHIGAN STATE BOARD OF PROFESSIONAL SURVEYORS, JAN. 28, 1971
REVISED MAY 14, 1975
REVISED JAN., 1983
REVISED OCT., 1995