

SURVEY &
REMONUMENTATION

MAR 03 1998

SECTION

KENT COUNTY REMONUMENTATION

LAND CORNER RECORDATION CERTIFICATE
Filing Requirement of Act 74, Mich. P.A. 1970

For corners in
KENT COUNTY

Located In:

Corner Code #

1. Public Land Survey

T R
T R
T R
T R

2. Property Controlling
in Section

S 7 T 6N R 9W

3. Miscellaneous
Property in Sec.

S T R
S T R

Wit. Mon. on
N-S 1/4 line

4. Lot No. _____, Recorded Plat _____
5. Private Claims _____

I, Kirk Breitels, in a field survey on Aug. 19, 1997 do hereby state that under requirements of P.A. 74, Michigan P.A. of 1970, the corner points mentioned in lines 1 and 2 above were in conformance with regulations and rules therefore as required in the current manual of survey instructions of the United States Department of the Interior, Bureau of Land Management or by a decree of a Court of Law and/or that the corner points mentioned in lines 3, 4 and 5 above were in conformance with the rules of the Michigan Board of Land Surveyors or by a Decree of a Court of Law; established, re-established, monumented, recovered, found as expressed below:

NOTE: Not more than 2 corners, all in the same town and range, may be recorded on this certificate.

A. Description of original monument and accessories and/or subsequent restoration:

Not Set by GLO

See LCRC # 10280 for Central 1/4 corner (B-4) of Sec. 7

B. Description of corner evidence found and/or method applied in restoring or reestablishing corner:

Established a point on the N-S 1/4 line per 1977 Consumers Power Co. survey 1591.69' North of the South 1/4 corner and 1040.71' South of the C 1/4 corner as referred to in "A".

The location described above is accepted by me and is generally accepted by professional surveyors as the best available evidence of the corner.

P.A. 345 1990 KENT COUNTY


PEER APPROVED 8/22/97

CHAIRMAN Harrison Huber

C. Description of monument for corner and accessories established to perpetuate locating the position of the corner:

Set Harrison Monument with witness cap at location described in "B"

PK Nail & tag in C/L RR	South	41.45'
Capped Rerod - CP Co.	North	19.34'
Nail & KC Remon. tag SE side P. Pole	S40°E	94.28'
Nail & KC Remon. tag W. side P. Pole	N10°W	293.51'
Nail & KC Remon. tag S. side E. gate post	N75°W	173.75'
NW corner barn extension	S35°W	110.75'

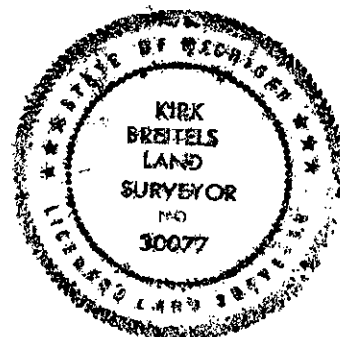

Signed by Kirk Breitels
Surveyor's Michigan License No. 30077

Date 10/30/97