

SURVEY & REMONUMENTATION

MAR 03 1998

SECTION

KENT COUNTY REMONUMENTATION

LAND CORNER RECORDATION CERTIFICATE Filing Requirement of Act 74, Mich. P.A. 1970

For corners in
KENT COUNTY

Located in:

Corner Code #

1. Public Land Survey

T___ R___
T___ R___
T___ R___
T___ R___

2. Property Controlling
in Section

S_2 T6N R9W

Wit. Mon. on
E-W 1/4 line

3. Miscellaneous
Property in Sec.

S___ T___ R___
S___ T___ R___

4. Lot No. _____, Recorded Plat _____
5. Private Claims _____

I, Kirk Breitels, in a field survey on Sept. 12, 1997 do hereby state that under requirements of P.A. 74, Michigan P.A. of 1970, the corner points mentioned in lines 1 and 2 above were in conformance with regulations and rules therefore as required in the current manual of survey instructions of the United States Department of the Interior, Bureau of Land Management or by a decree of a Court of Law and/or that the corner points mentioned in lines 3, 4 and 5 above were in conformance with the rules of the Michigan Board of Land Surveyors or by a Decree of a Court of Law; established, re-established, monumented, recovered, found as expressed below:

NOTE: Not more than 2 corners, all in the same town and range, may be recorded on this certificate.

A. Description of original monument and accessories and/or subsequent restoration:

Not Set by GLO

See LCRC # 10275 for Central 1/4 corner (J-2) of Sec. 2

B. Description of corner evidence found and/or method applied in restoring or reestablishing corner:

Surveys and description of parcels in the W 1/2 SW 1/4 of Sec. 2 refer to the E-W 1/4 line and the NE corner of the W 1/2 SW 1/4 of Sec. 2. "Young Addition" (Liber 46, Page 2) begins at the W 1/4 corner of Sec. 2 and it's North boundary is the E-W 1/4 line.

Found a "T" Iron at said NE corner of the W 1/2 SW 1/4 of Sec. 2. "T" Iron fits property Irons to South along the East line of the W 1/2 of the SW 1/4 as well as Irons referring to the E-W 1/4 line. Also fits Irons found ± in "Young Addition."

There is no C 1/4 corner of Sec. 2 (falls in Flat River) nor is there any other evidence of either a N-S or E-W 1/4 lines.

The "T" Iron per above is accepted by me and is generally accepted by professional surveyors as the best available evidence of the corner.

C. Description of monument for corner and accessories established to perpetuate locating the position of the corner:

Set Harrison Monument with witness cap in place of the "T" Iron

NW corner house foundation	S90°E 72.48'
Nail & KC Remon. tag W. side 14" Pine	S15°E 54.40'
Nail & KC Remon. tag NW side 18" Stump	S50°W 7.85'
Nail & KC Remon. tag SW side P. Pole	N40°W 14.56'
N-S chain link fence is 5.8' West	

other code # 6

REG. OF DEEDS

97 NOV 13 PM 1:01

STATE OF MICHIGAN
COUNTY OF KENT
RECEIVED FOR RECORD

10276

Register of Deeds Stamp & File Number


	A	B	C	D	E	F	G	H	I	J	K	L	M
1													
2	6		5		4		3		2		1		
3													
4	7		8		9		10		11		12		
5													
6	18		17		16		15		14		13		
7													
8	19		20		21		22		23		24		
9													
10	30		29		28		27		26		25		
11													
12	31		32		33		34		35		36		
13													

P.A. 345 1990 KENT COUNTY

PEER APPROVED 9/25/97

CHAIRMAN

Harry Hughes

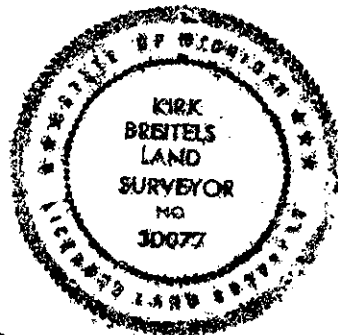

Signed by

Kirk Breitels

Date

10/30/97

Surveyor's Michigan License No.

30077