

SURVEY & REMONUMENTATION

MAR 03 1998

KENT COUNTY REMONUMENTATION

SECTION

LAND CORNER RECORDATION CERTIFICATE Filing Requirement of Act 74, Mich. P.A. 1970

For corners in

KENT COUNTY

(County)

Located In:

Corner Code #

1. Public Land Survey

T R
T R
T R
T R

2. Property Controlling in Section

S 11 T 6N R 9W

3. Miscellaneous Property in Sec.

S T R
S T R
S T R

Wit. Mon. on
E-W 1/4 line

4. Lot No. , Recorded Plat

5. Private Claims

I, Kirk Breitels, in a field survey on Sept. 18, 1997 do hereby state that under requirements of P.A. 74, Michigan P.A. of 1970, the corner points mentioned in lines 1 and 2 above were in conformance with regulations and rules therefore as required in the current manual of survey instructions of the United States Department of the Interior, Bureau of Land Management or by a decree of a Court of Law and/or that the corner points mentioned in lines 3, 4 and 5 above were in conformance with the rules of the Michigan Board of Land Surveyors or by a Decree of a Court of Law; established, re-established, monumented, recovered, found as expressed below:

NOTE: Not more than 2 corners, all in the same town and range, may be recorded on this certificate.

A. Description of original monument and accessories and/or subsequent restoration:

1959--Williams & Works--Surveys in the NE 1/4

See LCRC # 10272 for Central 1/4 corner (J-4) of Sec. 11

P.A. 345 1990 KENT COUNTY

PEER APPROVED: 9/29/97

CHAIRMAN Harry Hubert

B. Description of corner evidence found and/or method applied in restoring or reestablishing corner:

Found 1" x 12" Iron Pipe over a 1" x 24" Spike with stones around, at the intersection of the "E-W 1/4 line and E 1/8 line" per 1959 Williams & Works surveys. Iron(s) fit parcels as staked and occupied along the West side of Lowell View Dr. North (WW surveys) and parcels South (per tax map) of said E-W 1/4 line.


East 1/4 corner of Sec. 11 is East 1318.50'

The Iron Pipe/Spike is accepted by me and is generally accepted by professional surveyors as the best available evidence of the property controlling corner.

C. Description of monument for corner and accessories established to perpetuate locating the position of the corner:

Set Harrison Monument with witness cap in place of the Iron Pipe and Spike

Nail & KC Remon. tag E. side Tw. 24" Oak	S40°W	77.77'
Nail & KC Remon. tag NW side P. Pole	S60°W	44.08'
NE corner house foundation - #2391	N45°W	131.12'
Nail & KC Remon. tag E. side 20" Oak	N15°E	106.30'
Nail & KC Remon. tag S. side clust 15" Cherry	S85°E	17.73'

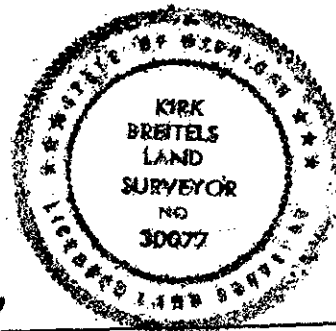

Signed by

Kirk Breitels

Date

10/30/97

Surveyor's Michigan License No.

30077