

# SURVEY & REMONUMENTATION

MAR 03 1998

KENT COUNTY REMONUMENTATION

STATE OF MICHIGAN  
COUNTY OF KENT  
RECEIVED FOR RECORD

97 APR 29 AM 8:28

## LAND CORNER RECORDATION CERTIFICATE Filing Requirement of Act 74, Mich. P.A. 1970

### SECTION

For corners in

KENT COUNTY

(County)

Located In:

Corner Code #

1. Public Land Survey

T R  
T R  
T R  
T R

2. Property Controlling in Section

S 35 T 7N R 9W Wit. Mon. on  
S line Sec. 35  
(for J-13)

3. Miscellaneous Property in Sec.

S T R  
S T R

"other"  
code #1

9906

Register of Deeds Stamp & File Number

4. Lot No. , Recorded Plat  
5. Private Claims

I, Kirk Breitels, in a field survey on Jan 14, 1997 do hereby state that under requirements of P.A. 74, Michigan P.A. of 1970, the corner points mentioned in lines 1 and 2 above were in conformance with regulations and rules therefore as required in the current manual of survey instructions of the United States Department of the Interior, Bureau of Land Management or by a decree of a Court of Law and/or that the corner points mentioned in lines 3, 4 and 5 above were in conformance with the rules of the Michigan Board of Land Surveyors or by a Decree of a Court of Law; established, re-established, monumented, recovered, found as expressed below:

NOTE: Not more than 2 corners, all in the same town and range, may be recorded on this certificate.

A	B	C	D	E	F	G	H	I	J	K	L	M
1												
2	6	5	4	3	2	1						
3												
4	7	8	9	10	11	12						
5												
6	18	17	16	15	14	13						
7												
8	19	20	21	22	23	24						
9												
10	30	29	28	27	26	25						
11												
12	31	32	33	34	35	36						
13												

A. Description of original monument and accessories and/or subsequent restoration:

GLO  
1991 LCRC #5770  
1995 LCRC #8251

Lyon Set Post  
Chettleburgh Set Kent County Witness Monument  
Byl Kent County Witness Monument

The position of this corner was previously approved by the Kent County Remonumentation Peer Group, monumented (witness monument) by Thomas M. Chettleburgh on 3/5/91 and was recorded per LCRC #5770.

B. Description of corner evidence found and/or method applied in restoring or reestablishing corner:


Found standard Kent Co. Witness Mon. (Harrison) per witnesses from above LCRC as set by Thomas M. Chettleburgh 629.68' East of the position of J-13 and 2019.84' West of K-13 (Kent Co. Mon.). Location of J-13 falls inside Atwood Corp. building.

LCRC #5770  
Remon. tag 16" Spruce N28°E 9.54' Nail & tag 16" Spruce N28°E 9.57'  
Remon. tag 32" Oak N78°E 59.55' Nail & tag 32" Oak N78°E 59.55'  
Remon. tag 28" W. Cherry S31°E 83.86' Nail & tag 28" W. Cherry S31°E 83.88'  
Remon. tag 20" W. Cherry S05°W 50.61' Nail & tag 20" W. Cherry S05°W 50.64'  
Remon. tag 14" Ash S12°W 23.03' Nail & tag 14" Ash S12°W 23.06'

The selected location is accepted by me and is generally accepted by professional surveyors as the best available evidence of the position of the corner.

C. Description of monument for corner and accessories established to perpetuate locating the position of the corner:

Standard Kent County Witness Monument  
Nail & KC Remon. tag SE side of 18" Spruce N28°E 9.57'  
Nail & KC Remon. tag S. side 34" Oak N78°E 59.60'  
Nail & KC Remon. tag SW side 30" W. Cherry S31°E 83.88'  
Nail & KC Remon. tag E. side 24" W. Cherry S05°W 50.67'  
Nail & KC Remon. tag E. side 16" Ash S12°W 23.06'  
8' high chain link fence S90°W 3.85'

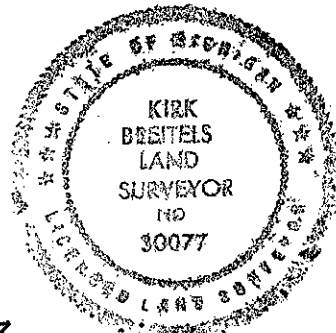

Signed by

*Kirk Breitels*

Date

3/27/97

Surveyor's Michigan License No.

30077

P.A. 345 1990 KENT COUNTY

PEER APPROVED 3/27/97

CHAIRMAN

*Harry Hubert*

FORM APPROVED BY MICHIGAN STATE BOARD OF PROFESSIONAL SURVEYORS, JAN. 28, 1971  
REVISED MAY 14, 1975  
REVISED JAN., 1983  
REVISED OCT., 1993