

SURVEY & REMONUMENTATION

\$7.00
\$2.00

MAR 08 1999

LAND CORNER RECORDATION CERTIFICATE
Filing Requirement of Act 74, Mich. P.A. 1970
KENT COUNTY REMONUMENTATION

For corners in SECTION

Kent (County)	Located in: Vergennes Township	Corner Code #
1. Public Land Survey	T <u>7N</u> R <u>9W</u>	<u>K-10S</u>
	T _____ R _____	_____
	T _____ R _____	<u>Witness Monument</u>
	T _____ R _____	_____
2. Property Controlling in Section	S _____ T _____ R _____	_____
	S _____ T _____ R _____	_____
3. Miscellaneous Property in Sec.	S _____ T _____ R _____	_____
	S _____ T _____ R _____	_____

STATE OF MICHIGAN
COUNTY OF KENT
RECEIVED FOR RECORD

98 DEC 14 AM 8:00


REG. OF DEEDS

Randy Kohler

other code # 8
11034

Register of Deeds Stamp & File Number

4. Lot No. _____, Recorded Plat _____
5. Private Claims _____

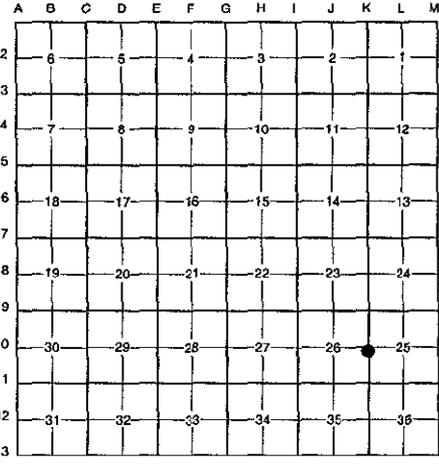

I, Randy Kolehouse, in a field survey on January 8 19 98, do hereby certify that under requirements of P.A. 74 Michigan P.A. of 1970, the corner points mentioned in lines 1 and 2 above were in conformance with regulations and rules therefore as required in the current manual of survey instructions of the United States Department of the interior, Bureau of Land Management or by a decree of a Court of Law and/or that the corner points mentioned in lines 3, 4 and 5 above were in conformance with the rules of the Michigan Board of Land Surveyors or by a Decree of a Court of Law; established, re-established, monumented, re-monumented, recovered, found as expressed below:

NOTE: Not more than 4 corners, all in the same town and range, may be recorded on this certificate.

A. Description of original monument and accessories and/or subsequent restoration:

K-10	1838	G.L.O. Notes	N. Brookfield	Set Post
	1989	L.C.R.C. #5228	John Bueche	Set K.C. Witness Mon. on East Line of Sec. 26
	1995	L.C.R.C. #8260	William Byl	K.C. Witness Monument

P.A. 345 1990 KENT COUNTY
PEER APPROVED 2/19/98
CHAIRMAN Randy Kohler

This corner was originally approved by the Kent County Remonumentation Peer Group and monumented by John Bueche on 10/2/89 and was recorded per L.C.R.C. #5228.

B. Description of corner evidence found and/or method applied in restoring or reestablishing corner:

K-10 Found a Standard Kent County Witness Monument on the C/L of Burroughs Road (gravel) on curve .80' below ground, on curve 15.0' South of drive to park, per L.C.R.C.'s #5228 and #8260 as set by John Bueche at witness corner to 1/4 corner between Sections 25 and 26 336.71' South of 1/4 corners on Section line.

L.C.R.C. #5228

L.C.R.C. #8260

- Nail & Remon. tag S side 18" Oak N 80° E 33.36'
- Nail & Remon. tag E side 12" Hickory N 10° W 45.76'
- Nail & Remon. tag E side 24" Beech S 0° W 60.60'
- Nail & Remon. tag NE side 8" Oak S 80° W 33.35'

- Nail & KKC Remon. tag S. side 21" Oak N80°E 33.36'
- Nail & KKC Remon. tag E. side 18" Hickory N10°W 45.79'
- Nail & KC Remon. tag E. side 27" Beech S00°W 60.60' (m. 60.62')
- Nail & KC Remon. tag NE side 10" Oak S80°W 33.36'

The selected location is accepted by me and is generally accepted by professional surveyors as the best available evidence of the position of the original corner.

C. Description of monument for corner and accessories established to perpetuate locating the position of the corner:

K-10 Standard Kent County Witness Monument

- Nail & K.C. remon. tag on S side 21" Oak N 80° E 33.36'
- Nail & K.C. remon. tag on E side 18" Hickory N 10° W 45.79'
- Nail & K.C. remon. tag on E side 27" Beech S 00° W 60.62'
- Nail & K.C. remon. tag on NE side 10" Oak S 80° W 33.36'
- C/L of gravel road on curve
- Drive to park, North 15.0'



Signed by Randy J. Kolehouse Date 12/4/98
EARTH TECH

Surveyor's Michigan License No. 25854