

SURVEY & REMONUMENTATION

MAR 08 1999

LAND CORNER RECORDATION CERTIFICATE Filing Requirement of Act 74, Mich. P.A. 1970 KENT COUNTY REMONUMENTATION

For corners in

SECTION

Kent
(County)

Located in: Vergennes
Township

Corner Code #

1. Public Land Survey

T 7N R 9W L-9W

T R

T R Witness Corner

T R

2. Property Controlling
in Section

S T R

S T R

3. Miscellaneous
Property in Sec.

S T R

S T R

4. Lot No. , Recorded Plat

5. Private Claims

I, Randy Kolehouse, in a field survey on January 15 19 98, do hereby certify that under requirements of P.A. 74 Michigan P.A. of 1970, the corner points mentioned in lines 1 and 2 above were in conformance with regulations and rules therefore as required in the current manual of survey instructions of the United States Department of the Interior, Bureau of Land Management or by a decree of a Court of Law and/or that the corner points mentioned in lines 3, 4 and 5 above were in conformance with the rules of the Michigan Board of Land Surveyors or by a Decree of a Court of Law; established, re-established, monumented, re-monumented, recovered, found as expressed below:

NOTE: Not more than 4 corners, all in the same town and range, may be recorded on this certificate.

A. Description of original monument and accessories and/or subsequent restoration:

L-9	1838	G.L.O. Notes	N. Brookfield	Set Post
	1989	L.C.R.C. #5224	John Bueche	Set K.C. Monument
	1995	L.C.R.C. #8271	William Byl	K.C. Witness Monument

P.A. 345 1990 KENT COUNTY

PEER APPROVED 12/15/98

CHAIRMAN Randy Kolehouse

This corner was originally approved by the Kent County Remonumentation Peer Group and monumented by John Bueche on 10/9/89 and was recorded per L.C.R.C. #5224.

B. Description of corner evidence found and/or method applied in restoring or reestablishing corner:

L-9 Found a Standard Kent County Witness Monument 1.5' North of a fence line running East and West, 75' West of the Northwest bank of the Flat River, and 15' East of a 2-track running North and South per L.C.R.C.'s #5224 and #8271 as set by John Bueche 1243.50' East of Section corner on the section between Sections 24-25.

L.C.R.C. #5224

L.C.R.C. #8271

Nail & Remon. tag in N side 12" Oak N 90° W 5.78'
Nail & Remon. tag in W side 8" Oak N 10° W 18.50'
Nail & Remon. tag in W side 32" Oak S 40° E 5.56' (m. 5.52')
Nail & Remon. tag in W side 24" Oak S 10° W 23.48' (23.50')
2 track N-S West 13' ±
Edge of water East 73' ±
Old fence E-W South 1.5' ±


Nail & KC Remon. tag N side 12" Oak N 90° W 5.78' (m. 5.80')
Nail & KC Remon. tag W. side 8" Oak N 10° W 18.50'
Nail & KC Remon. tag W. side 32" Oak S 40° E 5.53' (m. 5.52')
Nail & KC Remon. tag W. side 24" Oak S 10° W 23.46' (m. 23.50')
2 track N-S is West 13' m/l
Edge of water - East 73' m/l
Old fence E-W - South 1.5' m/l

The selected location is accepted by me and is generally accepted by professional surveyors as the best available evidence of the position of the original corner.

C. Description of monument for corner and accessories established to perpetuate locating the position of the corner:

L-9 Standard Kent County Witness Monument

Nail & K.C. remon. tag on N side 12" Oak N 90° W 5.80'
Nail & K.C. remon. tag on W side 8" Oak N 10° W 18.50'
Nail & K.C. remon. tag on W side 32" Oak S 40° E 5.52'
Nail & K.C. remon. tag on W side 24" Oak S 10° W 23.50'
Fence line running E-W, South 1.5'
Northwest bank of river, East 75'
2-track running N-S, West 15'

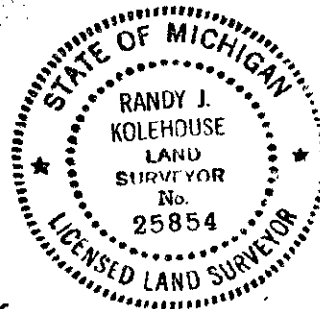

Signed by Randy J. Kolehouse Date 12/14/98

EARTH TECH

Surveyor's Michigan License No. 25854