

KENT COUNTY REMONUMENTATION

LAND CORNER RECORDATION CERTIFICATE

Filing Requirement of Act 74, Mich. P.A. 1970

ADA TOWNSHIP

For corners in
KENT COUNTY
(County)

Located In:

Corner Code #

1. Public Land Survey

T ___ R ___
T ___ R ___
T ___ R ___
T ___ R ___

Other Code

#6

2. Property Controlling
in Section

S 28 T 7 R 10
S ___ T ___ R ___

Wit. Mon. on

N&S 1/4 line

3. Miscellaneous
Property in Sec.

S ___ T ___ R ___
S ___ T ___ R ___

Sec. 28

4. Lot No. _____, Recorded Plat _____

5. Private Claims _____

I, William R. Byl, in a field survey on Dec. 28, 19 93, do hereby certify that under requirements of P.A. 74, Michigan P.A. of 1970, the corner points mentioned in lines 1 and 2 above were in conformance with regulations and rules therefore as required in the current manual of survey instructions of the United States Department of the Interior, Bureau of Land Management or by a decree of a Court of Law and/or that the corner points mentioned in lines 3, 4 and 5 above were in conformance with the rules of the Michigan Board of Land Surveyors or by a Decree of a Court of Law; established, re-established, monumented, re-monumented, recovered, found as expressed below:

NOTE: Not more than 4 corners, all in the same town and range, may be recorded on this certificate.

A. Description of original monument and accessories and/or subsequent restoration:

1970-Iron per Moore & Bruggink survey
1938-Iron per Williams & Works survey

B. Description of corner evidence found and/or method applied in restoring or reestablishing corner:

Found iron on N-S fence on N. side of Grand River, from Moore & Bruggink survey. Iron is approx. 20' East of line parallel with East Sec. line and 9.2' East of a straight line between North and South 1/4 corners.

C. Description of monument for corner and accessories established to perpetuate locating the position of the corner:

Replaced iron with Kent County Reference Monument
Set Nail & KC Remon. tag W. side 6" Mt. Ash
Set Nail & KC Remon. tag E. side P. Pole
Set Nail & KC Remon. tag S. side 16" Elm
Set Nail & KC Remon. tag E. side 6" Mt. Ash
N. bank of Grand River
Power line
Iron

S40°W 7.60'
S70°W 42.37'
N50°W 25.75'
N05°W 45.25'
South 105'
West 38'
South 60'

Signed by

Surveyor's Michigan License No.

Date

12-27-93

Note: See Survey L 258 P47 for Map

FORM APPROVED BY MICHIGAN STATE BOARD OF LAND SURVEYORS, JAN 28, 1971
REVISED MAY 14, 1975
REVISED JAN., 1983


STATE OF MICHIGAN
COUNTY OF KENT
RECEIVED
94 JAN -5 5:11:45

REG. OF DEEDS

6868

Register of Deeds Stamp & File Number

	A	B	C	D	E	F	G	H	I	J	K	L	M
2	6		5		4		3		2		1		
3													
4	7		8		9		10		11		12		
5													
6	18		17		16		15		14		13		
7													
8	19		20		21		22		23		24		
9													
10	30		29		28		27		26		25		
11													
12	31		32		33		34		35		36		
13													

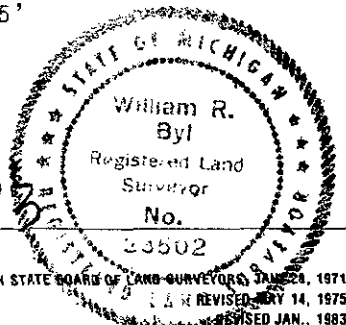


258



SCALE: 1" = 1000'

• KENT COUNTY MONUMENT

○ - KENT COUNTY REFERENCE MONUMENT

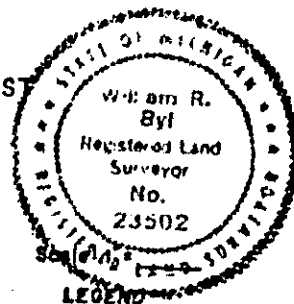

LEGEND

BEARING DATUM PER MDSH PROJ. NO. 41-10 (M-21)

William R. Byl, a Registered Surveyor in the State of Michigan, certify that I
 have surveyed the land shown and described hereon, that there are no encroachments
 except as illustrated, that the ratio of closure is no greater than 1/5000, and that
 we have complied with the provisions of Act #132, P.A. 1970. This survey was made
 in the attached legal description, which was given to me by the party certified to,
 was prepared by us from information given to us by the party certified to. Both map
 and description should be compared with the Abstract of Title or Title Policy for
 curacy, omissions, or encroachments.

- = set iron stake
- = found iron stake
- = set wood stake
- D = deed dimension
- R = recorded dimension
- M = measured dimension
- P = platting dimension
- = fence

WILLIAM R. BYL, INC.
REGISTERED LAND SURVEYORS
1549 Kalamezoo SE
Grand Rapids, Michigan 49507

Certified to: KENT CO. DESCRIPTION & MAPPING
Date: 12-29-93 930302