

KENT COUNTY REMONUMENTATION
ADA TWP.

LAND CORNER RECORDATION CERTIFICATE
Filing Requirement of Act 74, Mich. P.A. 1970

STATE OF MICHIGAN
COUNTY OF KENT
RECEIVED FOR RECORD

94 JUL -5 PM 3:12

For corners in
KENT COUNTY
(County)

Located In:

Corner Code #

1. Public Land Survey T R
T R
T R
T R
2. Property Controlling S 35 T 7N R 10W Wit. Mon. on
in Section S T R on S. line
3. Miscellaneous S T R Sec. 35
Property in Sec. S T R

Prop Control
Other Code # 11
6953

Register of Deeds Stamp & File Number

4. Lot No. , Recorded Plat
5. Private Claims

| | A | B | C | D | E | F | G | H | I | J | K | L | M |
|----|----|---|----|---|----|---|----|---|----|---|----|---|---|
| 2 | 6 | | 5 | | 4 | | 3 | | 2 | | | | |
| 3 | | | | | | | | | | | | | |
| 4 | 7 | | 8 | | 9 | | 10 | | 11 | | 12 | | |
| 5 | | | | | | | | | | | | | |
| 6 | 18 | | 17 | | 16 | | 15 | | 14 | | 13 | | |
| 7 | | | | | | | | | | | | | |
| 8 | 19 | | 20 | | 21 | | 22 | | 23 | | 24 | | |
| 9 | | | | | | | | | | | | | |
| 10 | 30 | | 29 | | 28 | | 27 | | 26 | | 25 | | |
| 11 | | | | | | | | | | | | | |
| 12 | 31 | | 32 | | 33 | | 34 | | 35 | | 36 | | |
| 13 | | | | | | | | | | | | | |

I, William R. Byl, in a field survey on Feb. 18, 19 94, do hereby certify that under requirements of P.A. 74, Michigan P.A. of 1970, the corner points mentioned in lines 1 and 2 above were in conformance with regulations and rules therefore as required in the current manual of survey instructions of the United States Department of the Interior, Bureau of Land Management or by a decree of a Court of Law and/or that the corner points mentioned in lines 3, 4 and 5 above were in conformance with the rules of the Michigan Board of Land Surveyors or by a Decree of a Court of Law; established, re-established, monumented, re-monumented, recovered, found as expressed below:

NOTE: Not more than 4 corners, all in the same town and range, may be recorded on this certificate.

A. Description of original monument and accessories and/or subsequent restoration:

Post set at meander corner on right side of Grand River per GLO survey

No other information available from the County Surveyor's Office, other surveying firms or any other sources.

P.A. 345 1990 KENT COUNTY

PEER APPROVED 3/24/94

CHAIRMAN Harry Hubert

B. Description of corner evidence found and/or method applied in restoring or reestablishing corner:

Did not find meander corner as set per GLO survey

Found 1/2" re-rod and 3/4" iron pipe on E-W fence near NE'ly bank of the Grand River. Fits surveys to the East. 27.1' North of a straight line between the SW and SE corners of Section 35. Replaced irons with a Kent County Reference Monument.

Corner "F" on recorded survey of Sec. 35-7-10


Recorded survey L26S P20

C. Description of monument for corner and accessories established to perpetuate locating the position of the corner:

Kent County Reference Monument

Set Nail & KC Remon. tag E. side 20" Basswood
Set Nail & KC Remon. tag S. side 10" Maple
Set Nail & KC Remon. tag S. side 15" Ash
Set Nail & KC Remon. tag E. side 15" Maple
Top of bank is West 7'
NE'ly bank of the Grand River is West 15' m/1

N10°E 16.56'
N80°E 30.17'
S75°E 36.12'
S40°E 25.40'

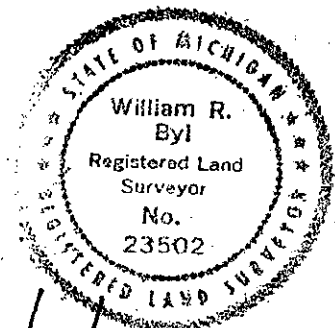

Signed by

William R. Byl

Date

06/27/94

Surveyor's Michigan License No.

23502

FORM APPROVED BY MICHIGAN STATE BOARD OF LAND SURVEYORS, JAN. 28, 1971
REVISED MAY 14, 1975
REVISED JAN., 1983