

SURVEY & REMONUMENTATION

MAR 03 1998

\$7.00
\$2.00

STATE OF MICHIGAN
COUNTY OF KENT
RECEIVED FOR RECORD

97 DEC 15 AM 10:41

SECTION

LAND CORNER RECORDATION CERTIFICATE Filing Requirement of Act 74, Mich. P.A. 1970 KENT COUNTY REMONUMENTATION

For corners in

| Kent (County) | Located in: | Ada Township | Corner Code # |
|---------------------------------------|-------------|-----------------|---------------|
| 1. Public Land Survey | T _____ | R _____ | _____ |
| | T _____ | R _____ | _____ |
| | T _____ | R _____ | Near B-4 |
| | T _____ | R _____ | _____ |
| 2. Property Controlling in Section | S <u>7</u> | T <u>7N</u> | R <u>10W</u> |
| | S _____ | T _____ | R _____ |
| 3. Miscellaneous Property in Sec. | S _____ | T _____ | R _____ |
| | S _____ | T _____ | R _____ |

Twigg
REG. OF DEEDS
"other" code #14
10349
Register of Deeds Stamp & File Number

4. Lot No. _____, Recorded Plat _____
5. Private Claims _____


I, Randy Kolehhouse, in a field survey on December 3 19 97, do hereby certify that under requirements of P.A. 74 Michigan P.A. of 1970, the corner points mentioned in lines 1 and 2 above were in conformance with regulations and rules therefore as required in the current manual of survey instructions of the United States Department of the Interior, Bureau of Land Management or by a decree of a Court of Law and/or that the corner points mentioned in lines 3, 4 and 5 above were in conformance with the rules of the Michigan Board of Land Surveyors or by a Decree of a Court of Law; established, re-established, monumented, re-monumented, recovered, found as expressed below:

NOTE: Not more than 4 corners, all in the same town and range, may be recorded on this certificate.

A. Description of original monument and accessories and/or subsequent restoration:

B-4 This corner was not originally set by the G.L.O.

1984 Survey L. 140 P. 15 Exxel Engineering 1/2" Rebar w/Exxel Cap

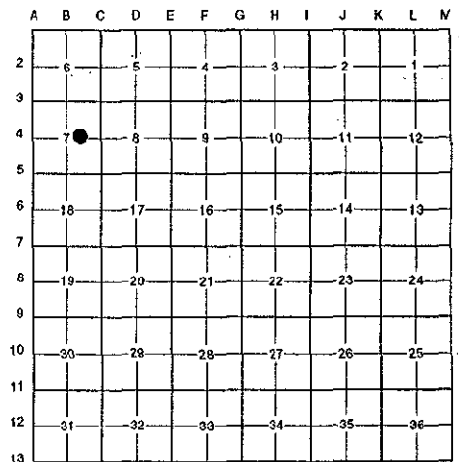

B. Description of corner evidence found and/or method applied in restoring or reestablishing corner:

B-4 Found a 1/2" rebar with an Exxel cap on the East-West 1/4 line (South line of Government Lot 2), 300' ± North of the C/L of Knapp Street and 25' East of the East edge of the Grand River as set by Exell Engineering and shown in survey recorded in L. 140 P. 15.

P.A. 345 1990 KENT COUNTY

PEER APPROVED 11/20/97


CHAIRMAN *Harry Huber*

The selected location is accepted by me and is generally accepted by professional surveyors as the best available evidence of the position of the original corner.

C. Description of monument for corner and accessories established to perpetuate locating the position of the corner:

B-4 Set a Standard Kent County Monument

Nail & K.C. remon. tag on W Face 24" Silver Maple S 05° E 18.27'
Nail & K.C. remon. tag on SW Face 18" Silver Maple S 45° E 20.06'
Nail & K.C. remon. tag on NW Face 40" Silver Maple N 50° E 59.72'
Nail & K.C. remon. tag on W Face 8" Maple N 10° W 40.80'
C/L Knapp Avenue South 300' ±
East edge of the Grand River West 25' ±

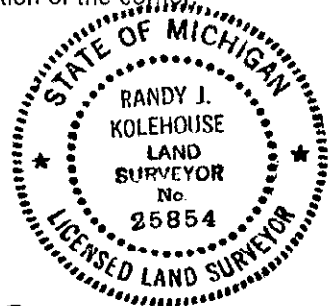

Signed by *Randy J. Kolehhouse*
EARTH TECH

Date 12/5/97

Surveyor's Michigan License No. 25854