

SURVEY & REMONUMENTATION

MAR 03 1998

\$7.00
\$2.00

SECTION

LAND CORNER RECORDATION CERTIFICATE Filing Requirement of Act 74, Mich. P.A. 1970 KENT COUNTY REMONUMENTATION

For corners in

Kent
(County)

Located in: Ada
Township

Corner Code #

1. Public Land Survey

T _____ R _____
T _____ R _____
T _____ R _____
T _____ R _____

2. Property Controlling
In Section

S 20 T 7N R 10W D-8

3. Miscellaneous
Property in Sec.

S _____ T _____ R _____ Ref. Mon. on
S _____ T _____ R _____ E-W 1/4 Line West
S _____ T _____ R _____ of Grand River

4. Lot No. _____, Recorded Plat _____

5. Private Claims _____

I, Randy Kolehhouse, in a field survey on December 4 19 97, do hereby certify that under requirements of P.A. 74 Michigan P.A. of 1970, the corner points mentioned in lines 1 and 2 above were in conformance with regulations and rules therefore as required in the current manual of survey instructions of the United States Department of the Interior, Bureau of Land Management or by a decree of a Court of Law and/or that the corner points mentioned in lines 3, 4 and 5 above were in conformance with the rules of the Michigan Board of Land Surveyors or by a Decree of a Court of Law; established, re-established, monumented, re-monumented, recovered, found as expressed below:

NOTE: Not more than 4 corners, all in the same town and range, may be recorded on this certificate.

A. Description of original monument and accessories and/or subsequent restoration:

D-8 This corner was not originally set by the G.L.O.

No information on record. Also checked Kent County Surveyor's witness map and found no information pertaining to this corner.

P.A. 345 1990 KENT COUNTY

PEER APPROVED 11/20/97

CHAIRMAN Harry Huber

B. Description of corner evidence found and/or method applied in restoring or reestablishing corner:


D-8 The Center of Section 20 falls in the Grand River. Set a capped rebar on the East-West fence line (occupied E-W 1/4 line) 80' West of the Southwest bank of the Grand River on line of a tree row running West as a property controlling corner.

The selected location is accepted by me and is generally accepted by professional surveyors as the best available evidence of the position of the original corner.

C. Description of monument for corner and accessories established to perpetuate locating the position of the corner:

D-8 Replaced Capped Rebar with a Standard Kent County Monument

Nail & K.C. remon. tag on S face 12" Ash S 65° E 25.34'
Nail & K.C. remon. tag on NE face 12" Elm S 30° E 17.62'
Nail & K.C. remon. tag on SE face 12" Elm S 45° W 42.28'
Nail & K.C. remon. tag on S face Twin 8" Ash N 90° W 22.05'
Nail & K.C. remon. tag on SW face 12" Honey Locust N 15° W 65.92'

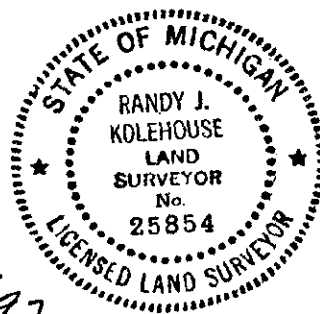

Signed by Randy J. Kolehhouse

Date 12/5/97

Surveyor's Michigan License No. 25854