

SURVEY & REMONUMENTATION

SEP 03 1999

LAND CORNER RECORDATION CERTIFICATE
Filing Requirement of Act 74, Mich. P.A. 1970
KENT COUNTY REMONUMENTATION

STATE OF MICHIGAN
COUNTY OF KENT
RECEIVED FOR RECORD

94 DEC -6 AM 9:02

For corners in
Kent **SECTION**
(County)

Located in: Corner Code #

- | | | | |
|------------------------------------|-------------|--------------|----------------|
| 1. Public Land Survey | T <u>7N</u> | R <u>11W</u> | |
| | T _____ | R _____ | Witness Corner |
| | T _____ | R _____ | South of G-1 |
| | T _____ | R _____ | |
| 2. Property Controlling in Section | S _____ | T _____ | R _____ |
| | S _____ | T _____ | R _____ |
| 3. Miscellaneous Property in Sec. | S _____ | T _____ | R _____ |
| | S _____ | T _____ | R _____ |

Prop Control
other code #4
7808
Register of Deeds Stamp & File Number

4. Lot No. _____, Recorded Plat _____
5. Private Claims _____

I, Randy Kolehhouse, in a field survey on July 5 19 94, do hereby certify that under requirements of P.A. 74 Michigan P.A. of 1970, the corner points mentioned in lines 1 and 2 above were in conformance with regulations and rules therefore as required in the current manual of survey instructions of the United States Department of the interior, Bureau of Land Management or by a decree of a Court of Law and/or that the corner points mentioned in lines 3, 4 and 5 above were in conformance with the rules of the Michigan Board of Land Surveyors or by a Decree of a Court of Law; established, re-established, monumented, re-monumented, recovered, found as expressed below:

NOTE: Not more than 4 corners, all in the same town and range, may be recorded on this certificate.

A. Description of original monument and accessories and/or subsequent restoration:

G-1	1831	G.L.O. Notes	Mullett	Set Post
	1992	L.C.R.C.	Marschall	Set K.C. Monument

A	B	C	D	E	F	G	H	I	J	K	L	V
2	6	5	4	3	2	1						
3												
4	7	8	9	10	11	12						
5												
6	18	17	16	15	14	13						
7												
8	19	20	21	22	23	24						
9												
10	30	29	28	27	26	25						
11												
12	31	32	33	34	35	36						
13												

This corner was originally approved by the Kent County Remonumentation Peer Group and monumented by Chris Marschall on 8/5/92 and was recorded per L.C.R.C. #6576A.

B. Description of corner evidence found and/or method applied in restoring or reestablishing corner:

G-1 Found standard Kent County Monument as witness corner as set by C. Marschall on west line of Section 3. Checks L.C.R.C. #6576A.

L.C.R.C. #6576A


P.A. 345 1999 KENT COUNTY
PEER APPROVED 11/3/94
CHAIRMAN *Randy Kolehhouse*

Nail & tag E side 20" Oak N 10° 36.57'
NE cor. of split log gar. hse. #2384 outside edge of 4th one up from bottom N 43° W 46.43'
SW cor. of split log gar. hse. #2384 outside edge of 4th one up from bottom N 70° W 63.40'
Nail & tag N side utl. pole S 39° W 119.19'
C/L "X" 4 Mile Road and Schimperle S 50° W 193.00' more or less
1/2" pipe S 57° E 34.48'
3/4" pipe in concrete N 0° E 41.81'

The selected location is accepted by me and is generally accepted by professional surveyors as the best available evidence of the position of the original corner.

C. Description of monument for corner and accessories established to perpetuate locating the position of the corner:

G-1 Standard Kent County Monument (Witness Corner)
Nail & K.C. remon. tag E side 20" Oak N 10° 36.57'
NE cor. of split log gar. hse. #2384 outside edge of 4th one up from bottom N 37° W 46.43'
SW cor. of split log gar. hse. #2384 outside edge of 4th one up from bottom N 62° W 63.40'
Nail & K.C. remon. tag N side utl. pole S 45° W 119.19'
C/L "X" 4 Mile Road and Schimperle S 50° W 193' more or less
1/2" pipe S 57° E 34.48'
3/4" pipe in concrete N 0° E 41.81'

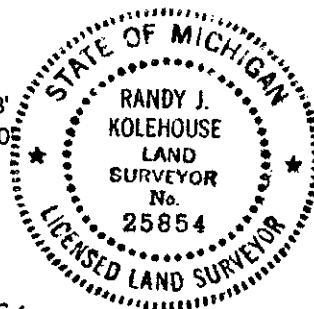

Signed by *Randy J. Kolehhouse* Date 12/1/94
Surveyor's Michigan License No. 25854