

Kent County Remonumentation 93 MAY 13 AM 9:07
LAND CORNER RECORDATION CERTIFICATE
Filing Requirement of Act 74, Mich. P.A. 1970

For corners in

Kent

(County)

Located In:
Grattan Twp.

Corner Code #

REC. BY DEEDS

1. Public Land Survey

T 8-N R 9-W

D-5 Witness

T R

T R

T R

2. Property Controlling
in Section

S 17 T 8-N R 9-W

South of D-5

South side of

3. Miscellaneous
Property in Sec.

S T R

Toohey Lake

on 1/4 Line.

6775

Register of Deeds Stamp & File Number

4. Lot No. , Recorded Plat

5. Private Claims

I, Thomas Starr, in a field survey on March 15, 1993, do hereby certify that under requirements of P.A. 74, Michigan P.A. of 1970, the corner points mentioned in lines 1 and 2 above were in conformance with regulations and rules therefore as required in the current manual of survey instructions of the United States Department of the Interior, Bureau of Land Management or by a decree of a Court of Law and/or that the corner points mentioned in lines 3, 4 and 5 above were in conformance with the rules of the Michigan Board of Land Surveyors or by a Decree of a Court of Law; established, re-established, monumented, re-monumented, recovered, found as expressed below:

NOTE: Not more than 4 corners, all in the same town and range, may be recorded on this certificate.

A. Description of original monument and accessories and/or subsequent restoration:

D-5

Falls in Toohey Lake

GLO offset around lake with no points set

Corner location established by Moore & Bruggink - 1972

Survey - Recorded - Liber 1, Page 50.

B. Description of corner evidence found and/or method applied in restoring or reestablishing corner:

Re-established corner location from Moore & Bruggink - 1972
Survey and Surveys By Williams & Works and ExxelFor Section 17 - Sectional Survey
See Recorded Survey - Liber 253, Page 43.For Section 8 - Sectional Survey
See Recorded Survey - Liber 253, Page 44.C. Description of monument for corner and accessories established to perpetuate locating the position of the corner:
Set Standard Kent County Monument with Witness Cap - 355.00' South of
North 1/4 Corner of Section 17, Witness

Nail & Tag in W. side 6" Maple

S20°E 37.31'

Nail & Tag in S. side 18" Oak

S80°E 19.71'

Nail & Tag in W. side 6" Maple

N35°E 19.57'

Nail & Tag in W. side 8" Beech

N05°W 27.52'

Nail & Tag in W. side 30" Beech

N50°W 20.78'

Nail & Tag in N. side 6" Maple

S80°W 43.30'

Top of Bank - on edge of woods line - South



Signed by

Thomas C. Starr


Date

5-11-93Surveyor's Michigan License No. 25874

For: K.C. REMONUMENTATION

Recorded in Liber 262 of surveys Page 143

SECTION 17
T-8-N, R-9-W
Gratton Twp.

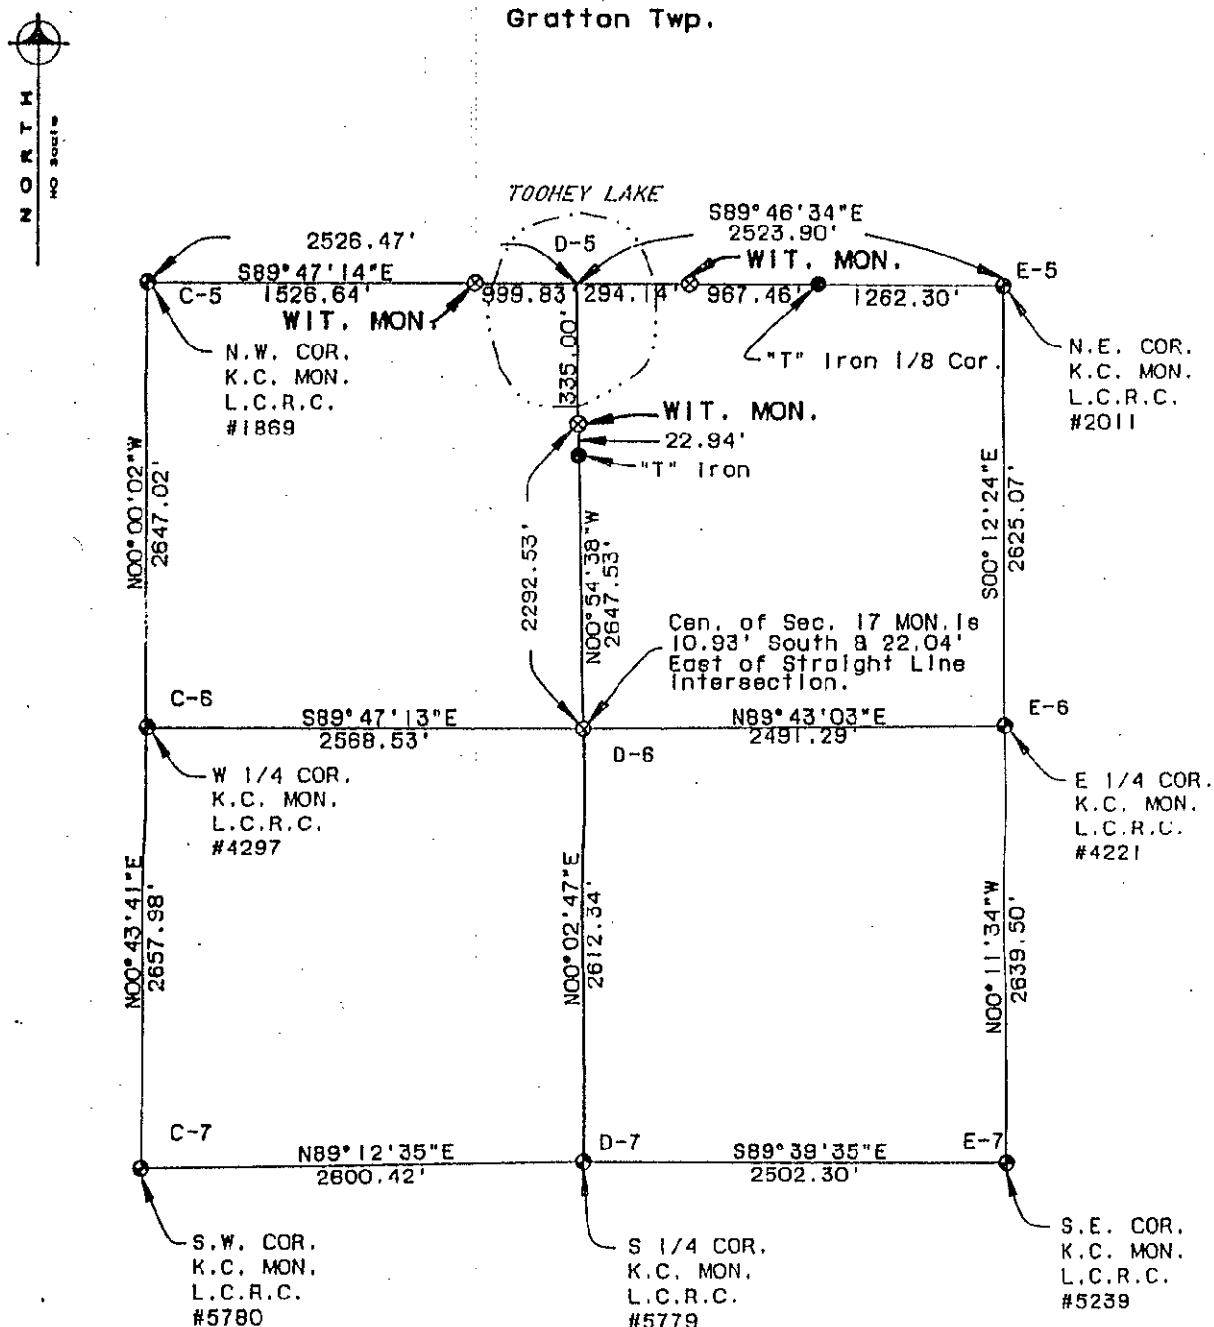

I HEREBY CERTIFY THAT THIS SURVEY MEETS ALL OF THE REQUIREMENTS OF P.A. 132-1970.

- IRON STAKE(FOUND)
- ⊕ MONUMENT (SET)
- ⊙ MONUMENT
- WOOD STAKE
- X-X FENCE LINE
- R RECORDED DIMENSION
- D DEED DIMENSION
- M MEASURED DIMENSION
- C CENTER LINE



omm engineering, inc.
civil engineers/surveyors
1550 east beltline, se.
grand rapids, mi. 49506
616-957-4350



Thomas C. Stearn

THOMAS C. STARR
Registered Land Surveyor
No. 25874

Project No. 92035

Date: 3-24-93

For: K.C. REMONUMENTATION

State of Michigan,


Kent County Register of Deeds

This survey was received for record

on the 13th day of May, 1993 at 11 A.M.

Recorded in Liber 253 of surveys Page 44

SECTION 8
T-8-N, R-9-W
GRATTON TWP.

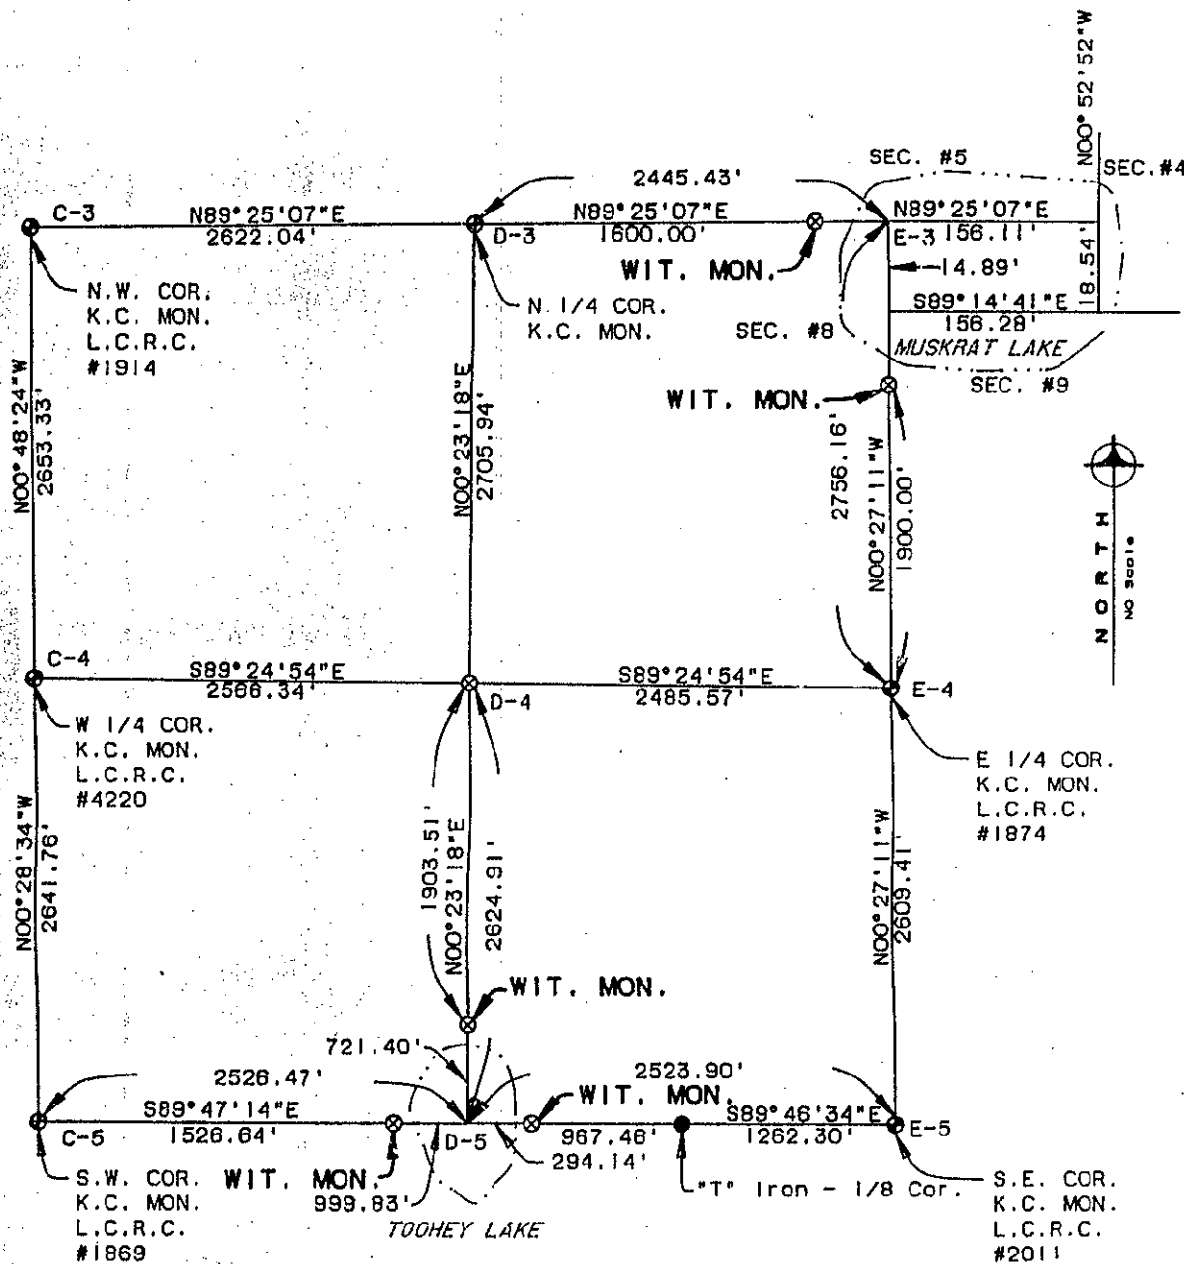

Note: All Bearings Based on Solar Observation

I HEREBY CERTIFY THAT THIS SURVEY MEETS ALL OF THE REQUIREMENTS OF P.A. 132-1978.

LEGEND

- IRON STAKE (FOUND)
- ⊗ MONUMENT (SET)
- ⊙ MONUMENT
- WOOD STAKE
- X FENCE LINE
- R RECORDED DIMENSION
- D DEED DIMENSION
- M MEASURED DIMENSION
- C CENTER LINE



omm engineering, inc.
civil engineers/surveyors
1550 east beltline, s.e.
grand rapids, mi. 49506
616-957-4350



Thomas C. Starr

THOMAS C. STARR
Registered Land Surveyor
No. 25874