

Kent County Remonumentation
LAND CORNER RECORDATION CERTIFICATE
Filing Requirement of Act 74, Mich. P.A. 1970

STATE OF MICHIGAN
COUNTY OF KENT
RECEIVED FOR RECORD
MAY 13 AM 9:07

For corners in

Kent
(County)

Located In:
Grattan Twp.

Corner Code ##

1. Public Land Survey

T 8-N R 9-W

E-3 Witness

T _____ R _____

T _____ R _____

T _____ R _____

2. Property Controlling
in Section

S 8 T 8-N R 9-W

South of E-3

S 9 T 8-N R 9-W

South side of

3. Miscellaneous
Property in Sec.

S _____ T _____ R _____

Muskrat Lake

S _____ T _____ R _____

on N. & S. Sec. line.

Register of Deeds Stamp & File Number

4. Lot No. _____, Recorded Plat _____

5. Private Claims _____

I, Thomas Starr, in a field survey on March 15, 19 93,
do hereby certify that under requirements of P.A. 74, Michigan P.A. of 1970, the corner points mentioned
in lines 1 and 2 above were in conformance with regulations and rules therefore as required in the
current manual of survey instructions of the United States Department of the Interior, Bureau of Land
Management or by a decree of a Court of Law and/or that the corner points mentioned in lines 3, 4 and 5
above were in conformance with the rules of the Michigan Board of Land Surveyors or by a Decree of a
Court of Law, established, re-established, monumented, re-monumented, recovered, found as
expressed below:

NOTE: Not more than 4 corners, all in the same town and range, may be recorded
on this certificate.

A. Description of original monument and accessories and/or subsequent restoration:

E-3

Falls in Muskrat Lake

GL0 traversed around lake with meander corners.

B. Description of corner evidence found and/or method applied in restoring or reestablishing corner:

Establishes East line of Section 8 by holding straight line
from E-5 through E-4 North to Muskrat Lake.

For Section 8 - Sectional Survey

See Recorded Survey - Liber 253, Page 47.

For Section 9 - Sectional Survey

See Recorded Survey - Liber 253, Page 42.

C. Description of monument for corner and accessories established to perpetuate locating the position of the corner:

Set Standard Kent County Monument with Witness Cap - 1900.00' North of E-4
Witness

Nail & Tag in N. side 12" Ash
Nail & Tag in N. side 14" Ash
Nail & Tag in E. side Twin 12" Maple
Nail & Tag in W. side 16" Oak
Nail & Tag in S. side 6" Maple
Nail & Tag in W. side 12" Maple

N85°W	10.64'
N50°W	15.97'
N15°W	23.10'
N15°E	14.43'
N80°E	4.65'
Due South	21.90'

Signed by

Thomas C. Starr

Date


5-11-93

Surveyor's Michigan License No. 25874

For: K.C. REMONUMENTATION

Recorded in Liber 262 of surveys Page 111

SECTION 8
T-8-N, R-9-W
GRATTON TWP.

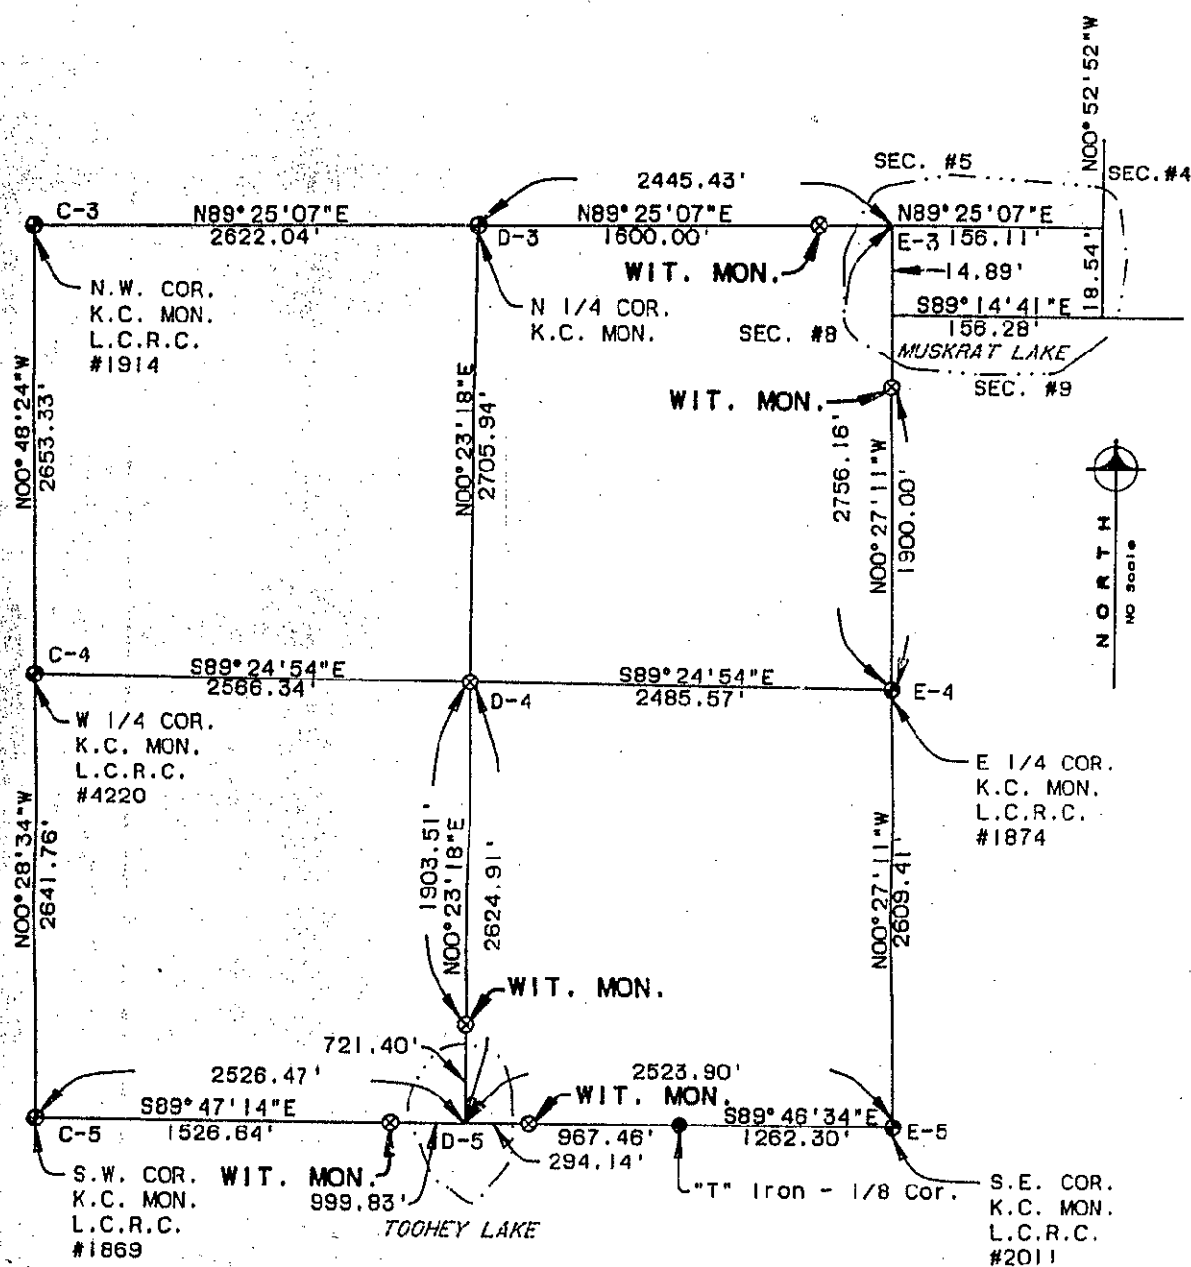


I HEREBY CERTIFY THAT THIS SURVEY MEETS ALL OF THE REQUIREMENTS OF P.A. 132-1970.

- IRON STAKE(FOUND)
- ⊗ MONUMENT (SET)
- ⊙ MONUMENT
- WOOD STAKE
- X * FENCE LINE
- R RECORDED DIMENSION
- D DEED DIMENSION
- M MEASURED DIMENSION
- C CENTER LINE



omm engineering, inc.
civil engineers/surveyors
1550 east beltline, se.
grand rapids, mi. 49506
616-957-4350

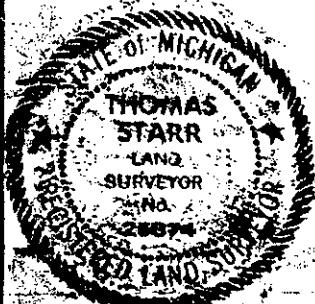

Thomas C. Stow

THOMAS C. STARR
Registered Land Surveyor
No. 25874