

STATE OF MICHIGAN
COUNTY OF KENT
RECEIVED FOR RECORD

Kent County Remonumentation
LAND CORNER RECORDATION CERTIFICATE
Filing Requirement of Act 74, Mich. P.A. 1970

93 MAY 13 AM 9:07

For corners in

Kent

(County)

Located in:
Grattan Twp.

Corner Code #

1. Public Land Survey

T 8-N R 9-W

D-5 Witness

T R

T R

T R

Other Code #6

2. Property Controlling
in Section

S 8 T 8-N R 9-W

North of D-5

S T R

North side of

3. Miscellaneous
Property in Sec.

S T R

Toohy Lake

S T R

on 1/4 Line.

REG. OF DEEDS

6773

Register of Deeds Stamp & File Number

4. Lot No. , Recorded Plat

5. Private Claims

I, Thomas Starr, in a field survey on March 15, 19 93,
do hereby certify that under requirements of P.A. 74, Michigan P.A. of 1970, the corner points mentioned
in lines 1 and 2 above were in conformance with regulations and rules therefore as required in the
current manual of survey instructions of the United States Department of the Interior, Bureau of Land
Management or by a decree of a Court of Law and/or that the corner points mentioned in lines 3, 4 and 5
above were in conformance with the rules of the Michigan Board of Land Surveyors or by a Decree of a
Court of Law; established, re-established, monumented, re-monumented, recovered, found as
expressed below:

NOTE: Not more than 4 corners, all in the same town and range, may be recorded
on this certificate.

A. Description of original monument and accessories and/or subsequent restoration:

D-5

Falls in Toohy Lake

GLO offset around lake with no points set

Corner location established by Moore & Bruggink - 1972

Survey - Recorded - Liber 1, Page 50.

B. Description of corner evidence found and/or method applied in restoring or reestablishing corner:

Re-established corner location and found iron North of Toohy Lake
per 1972 Recorded Survey

For Section 8 - Sectional Survey

See Recorded Survey - Liber 253, Page 44.

For Section 17 - Sectional Survey

See Recorded Survey - Liber 253, Page 43.

C. Description of monument for corner and accessories established to perpetuate locating the position of the corner:

Replaced iron with Standard Kent County Monument with Witness Cap - 721.40'
North of South 1/4 Corner of Section 8, Witness

Nail & Tag in S. side 8" Ash

S85°W 73.45'

Nail & Tag in E. side Twin 28" Willow

N30°W 62.43'

Nail & Tag in W. side 8" Oak

N30°E 52.95'

Nail & Tag in W. side 14" Apple

N55°E 58.25'

Nail & Tag in W. side Tripple 4" Willow

S25°E 63.72'

Old N. & S. Fence Line is 2.5' East



Signed by

Thomas C. Starr

Date

5-11-93

Surveyor's Michigan License No. 25874

Project No. 92035

Date: 3-24-93

For: K.C. REMONUMENTATION

State of Michigan,


Kent County Register of Deeds

This survey was received for record

on the 13th day of May, 1993 at 11 A.M.

Recorded in Liber 253 of surveys Page 44.

SECTION 8
T-8-N, R-9-W
GRATTON TWP.

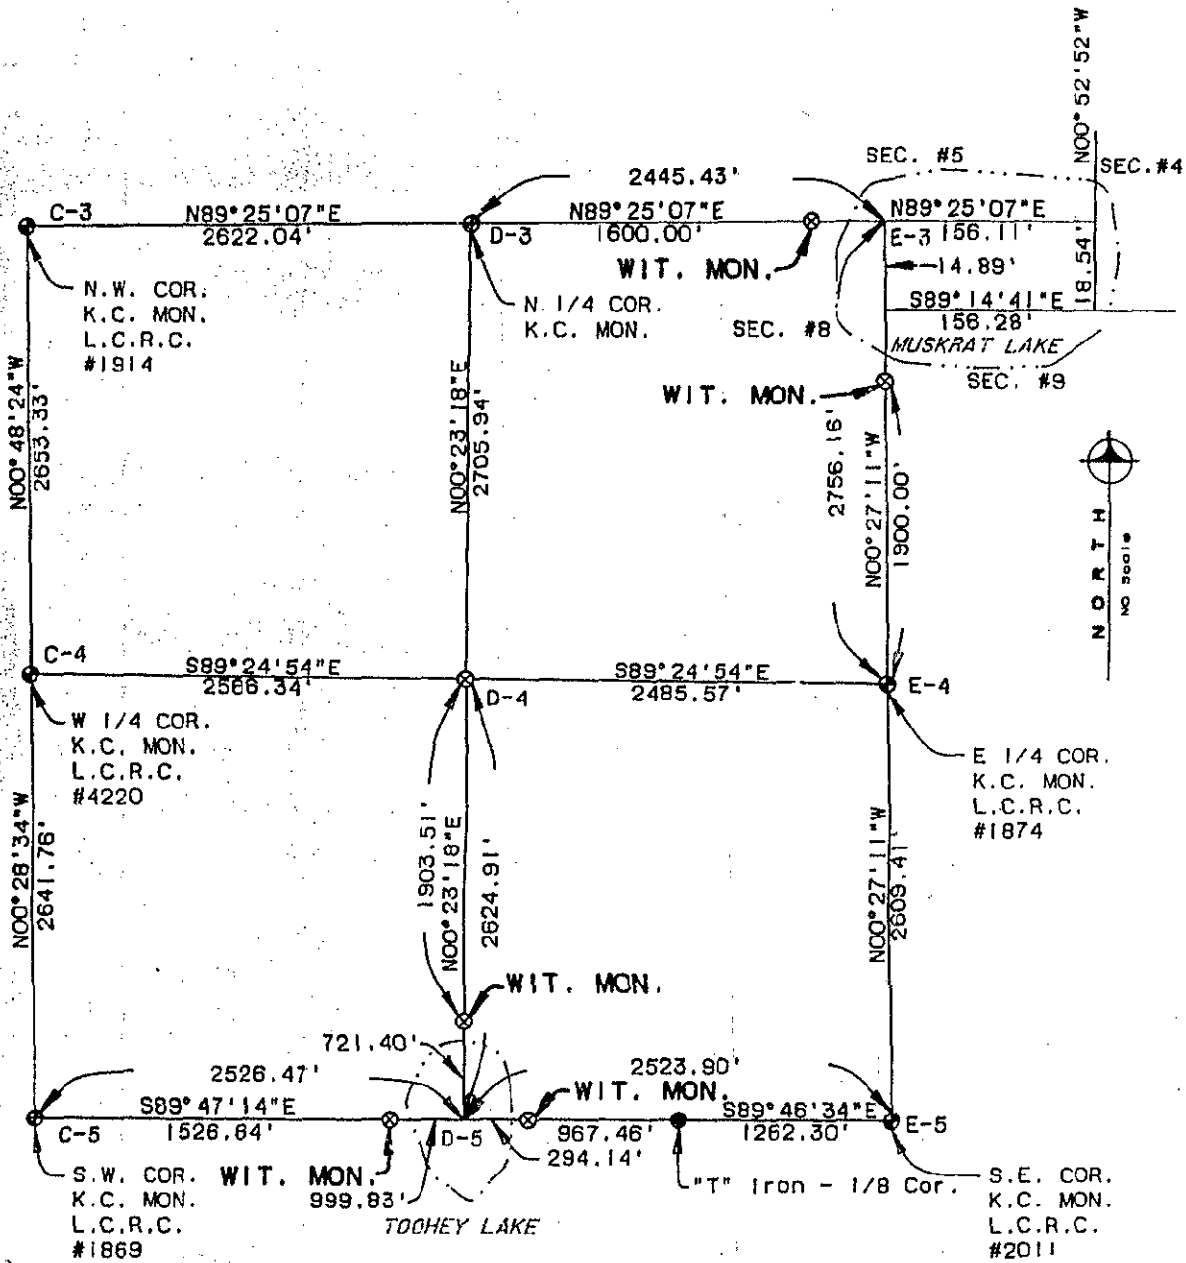

Note: All Bearings Based on Solar Observation


I HEREBY CERTIFY THAT THIS SURVEY MEETS ALL OF THE REQUIREMENTS OF P.A. 132-1978.

LEGEND

- IRON STAKE (FOUND)
- ⊗ MONUMENT (SET)
- ⊙ MONUMENT
- WOOD STAKE
- X FENCE LINE
- R RECORDED DIMENSION
- D DEED DIMENSION
- H MEASURED DIMENSION
- E CENTER LINE



omm engineering, inc.
civil engineers/surveyors
1550 east beltline, se.
grand rapids, mi. 49506
616-957-4350

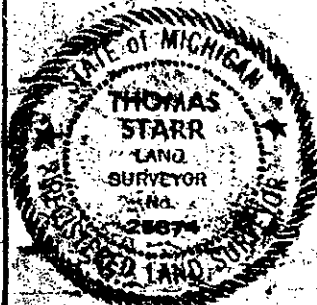

Thomas C. Starr

THOMAS C. STARR
Registered Land Surveyor
No. 25874

Project No. 92035

Date: 5-04-93

For: K.C. REMONUMENTATION

State of Michigan,

Kent County Register of Deeds

This survey was received for record



on the 13th day of May, 1993 at 11 A.M.

Recorded in Liber 253 of surveys Page 43

SECTION 17

T-8-N, R-9-W

Grafton Twp.

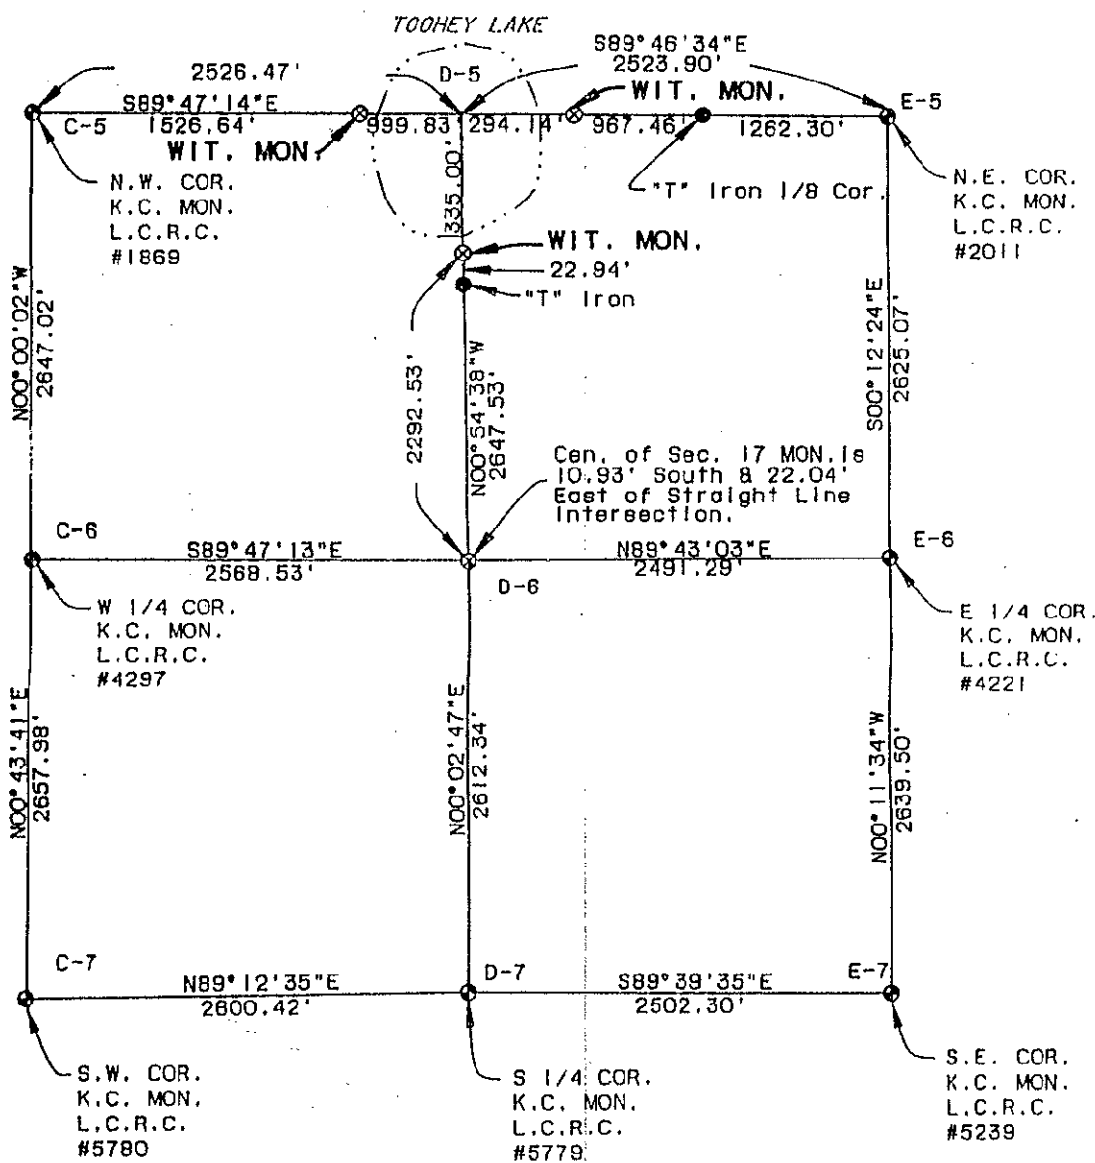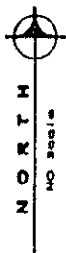

Note: All Bearings Based on Solar Observation


I HEREBY CERTIFY THAT THIS SURVEY MEETS ALL OF THE REQUIREMENTS OF P.A. 132-1978.

LEGEND

- IRON STAKE (FOUND)
- ⊕ MONUMENT (SET)
- ⊙ MONUMENT
- WOOD STAKE
- X-FENCE LINE
- R RECORDED DIMENSION
- D DEED DIMENSION
- M MEASURED DIMENSION
- E CENTER LINE



omm engineering, Inc.
civil engineers/surveyors
1550 east beltline, se.
grand rapids, mi. 49506
616-957-4350

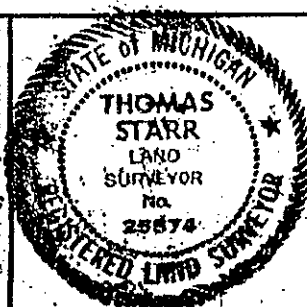

Thomas C. Starr

THOMAS C. STARR
Registered Land Surveyor
No. 25874