

Kent County Remonumentation
LAND CORNER RECORDATION CERTIFICATE
Filing Requirement of Act 74, Mich. P.A. 1970

93 MAY 13 AM 9:07

For corners in

Kent

(County)

Located in:
Grattan Twp.

Corner Code ##

1. Public Land Survey

T 8-N R 9-W

E-3 Witness

T _____ R _____

T _____ R _____

T _____ R _____

Other Code # 72. Property Controlling
in SectionS 4 T 8-N R 9-W

North of E-3

S 5 T 8-N R 9-W

North side of

3. Miscellaneous
Property in Sec.

S _____ T _____ R _____

Muskrat Lake

S _____ T _____ R _____

on N. & S. Sec. Line

Register of Deeds Stamp & File Number

6777

4. Lot No. _____, Recorded Plat _____

5. Private Claims _____

I, Thomas Starr, in a field survey on March 15, 1993, do hereby certify that under requirements of P.A. 74, Michigan P.A. of 1970, the corner points mentioned in lines 1 and 2 above were in conformance with regulations and rules therefore as required in the current manual of survey instructions of the United States Department of the Interior, Bureau of Land Management or by a decree of a Court of Law and/or that the corner points mentioned in lines 3, 4 and 5 above were in conformance with the rules of the Michigan Board of Land Surveyors or by a Decree of a Court of Law; established, re-established, monumented, re-monumented, recovered, found as expressed below:

NOTE: Not more than 4 corners, all in the same town and range, may be recorded on this certificate.

A. Description of original monument and accessories and/or subsequent restoration:

E-3

Falls in Muskrat Lake

GLO. traversed around lake with meander corners

B. Description of corner evidence found and/or method applied in restoring or reestablishing corner:

Established East Line of Section 5 by holding found all points capped iron 1860.50' South of E-2.

For Section 4 - Sectional Survey

See Recorded Survey Liber 253, Page 40.

For Section 5 - Sectional Survey

See Recorded Survey Liber 253, Page 41.

C. Description of monument for corner and accessories established to perpetuate locating the position of the corner:

Set Standard Kent County Monument with witness cap - 1880.00' South of E-2
Witness

Nail & Tag in E. side 4" Oak

Nail & Tag in E. side 36" Oak

Nail & Tag in S. side 8" Thornapple

Nail & Tag in E. side 4" Oak

North and South fence line - 5.1' - West
19.5' North to Iron.

Due North 3.44'

N25°E 25.10'

S80°E 7.48'

S20°W 8.75'




Signed by

Thomas C. Starr

Date


5-11-93Surveyor's Michigan License No. 25874

State of Michigan,
Kent County Register of Deeds
This survey was received for record
on the 9th day of March, 1993 at 2:00 P.M.
Recorded in Liber 252 of surveys Page 449

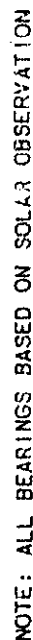

I HEREBY CERTIFY THAT THIS SURVEY MEETS ALL OF THE REQUIREMENTS OF P.A. 132-1978.

- Omni**
 civil engineering, inc.
 civil engineers/surveyors
 1550 east bottling, ca.
 grand rapids, mi. 49506
 616-257-4850

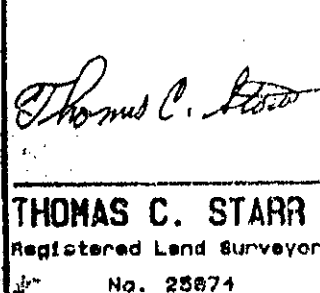

Project No. 92035

Date: 3-24-93

For: K.C. REMONUMENTATION

State of Michigan,

Kent County Register of Deeds

This survey was received for record


on the 13th day of May, 1993 at 11 A.M.

Recorded in Liber 253 of surveys Page 44.

Section 5

T-8-N, R-9-W

Grafton Twp.

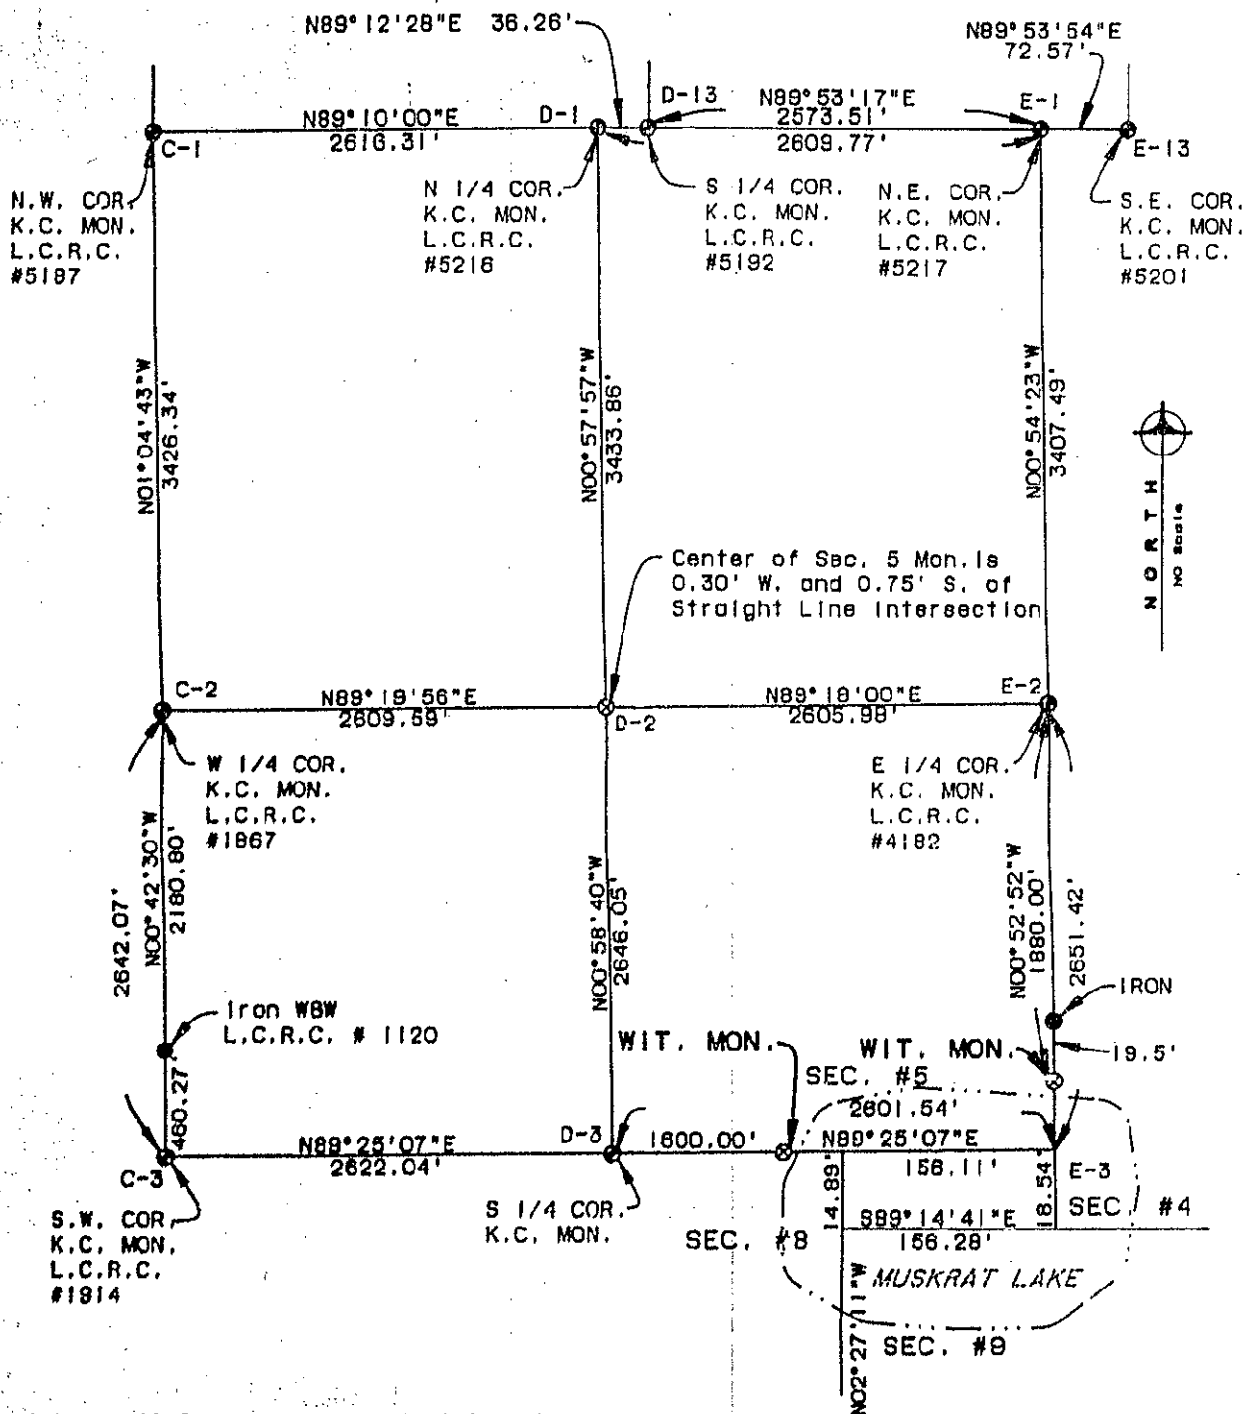

Note: All Bearings Based on Solar Observation

I HEREBY CERTIFY THAT THIS SURVEY MEETS ALL OF THE REQUIREMENTS OF P.A. 132-1979.

LEGEND

- IRON STAKE (FOUND)
- MONUMENT (SET)
- MONUMENT
- WOOD STAKE
- FENCE LINE
- R RECORDED DIMENSION
- D DEED DIMENSION
- M MEASURED DIMENSION
- CENTER LINE



oma engineering, inc.
civil engineers/surveyors
1550 east beltline, se.
grand rapids, mi. 49506
616-957-4350



Thomas C. Starr

THOMAS C. STARR
Registered Land Surveyor
No. 25874